

Gidw.

PROJECT Phase II SHEET _____ OF _____


SUBJECT _____ DATE 7-25-18

JOB NO. 4447

BY AHAS

300 S. Pearl

← N

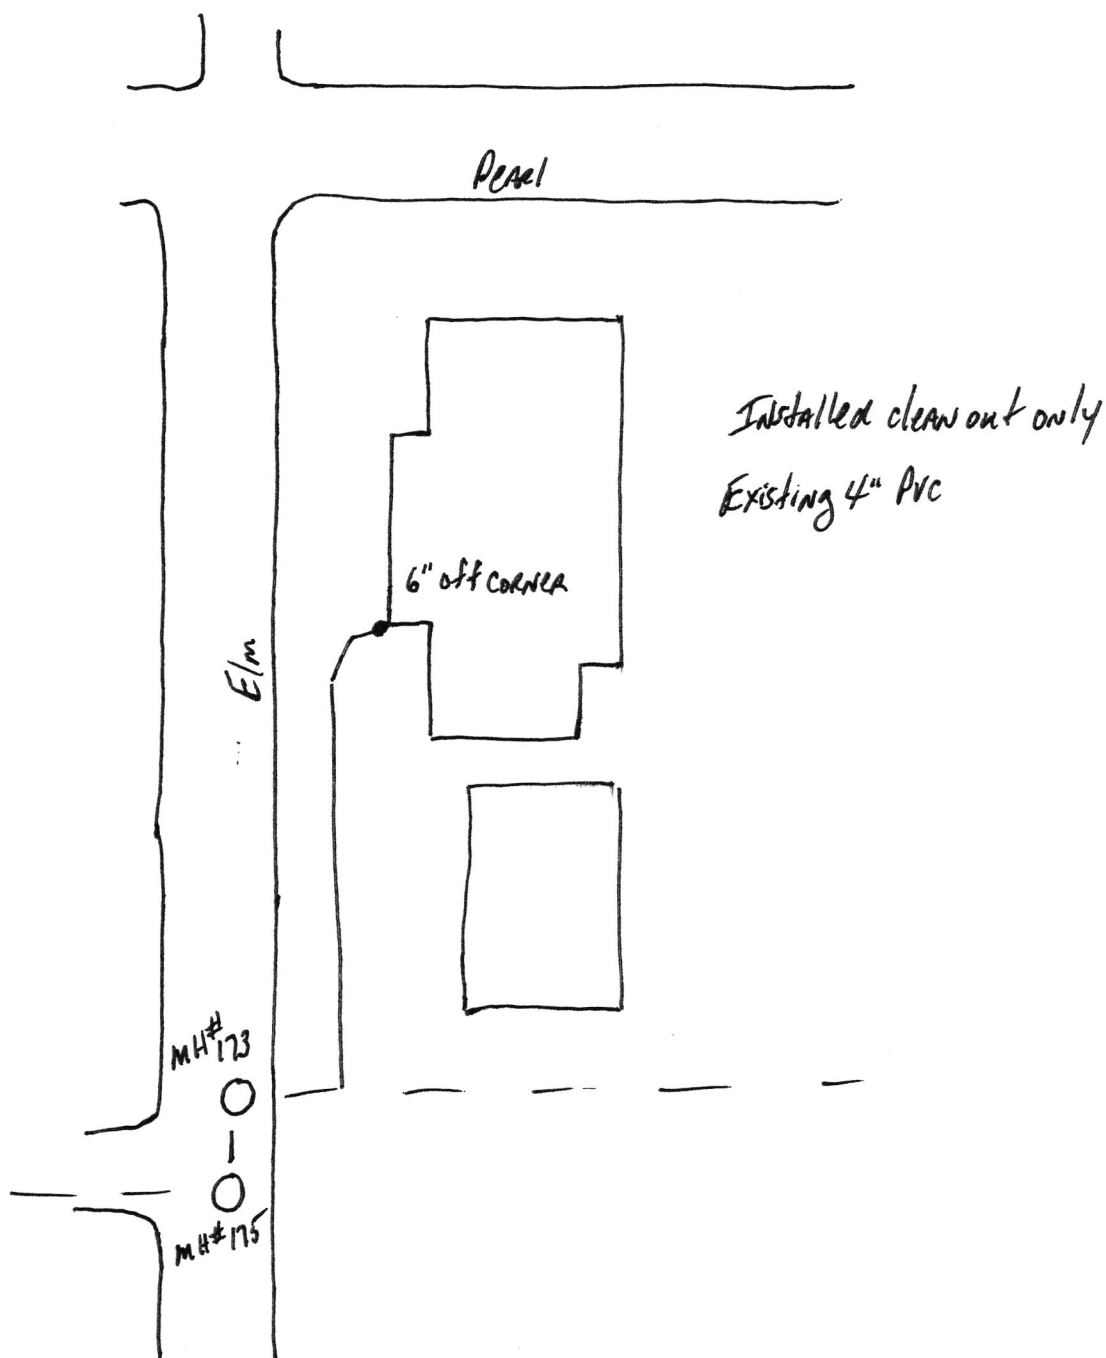

300 Pearl

SRT Phase II

7.30.18

