

Gidw.

PROJECT

Phase II

SHEET

OF

SUBJECT

DATE


6-25-18

JOB NO.

4447

BY


Atlas

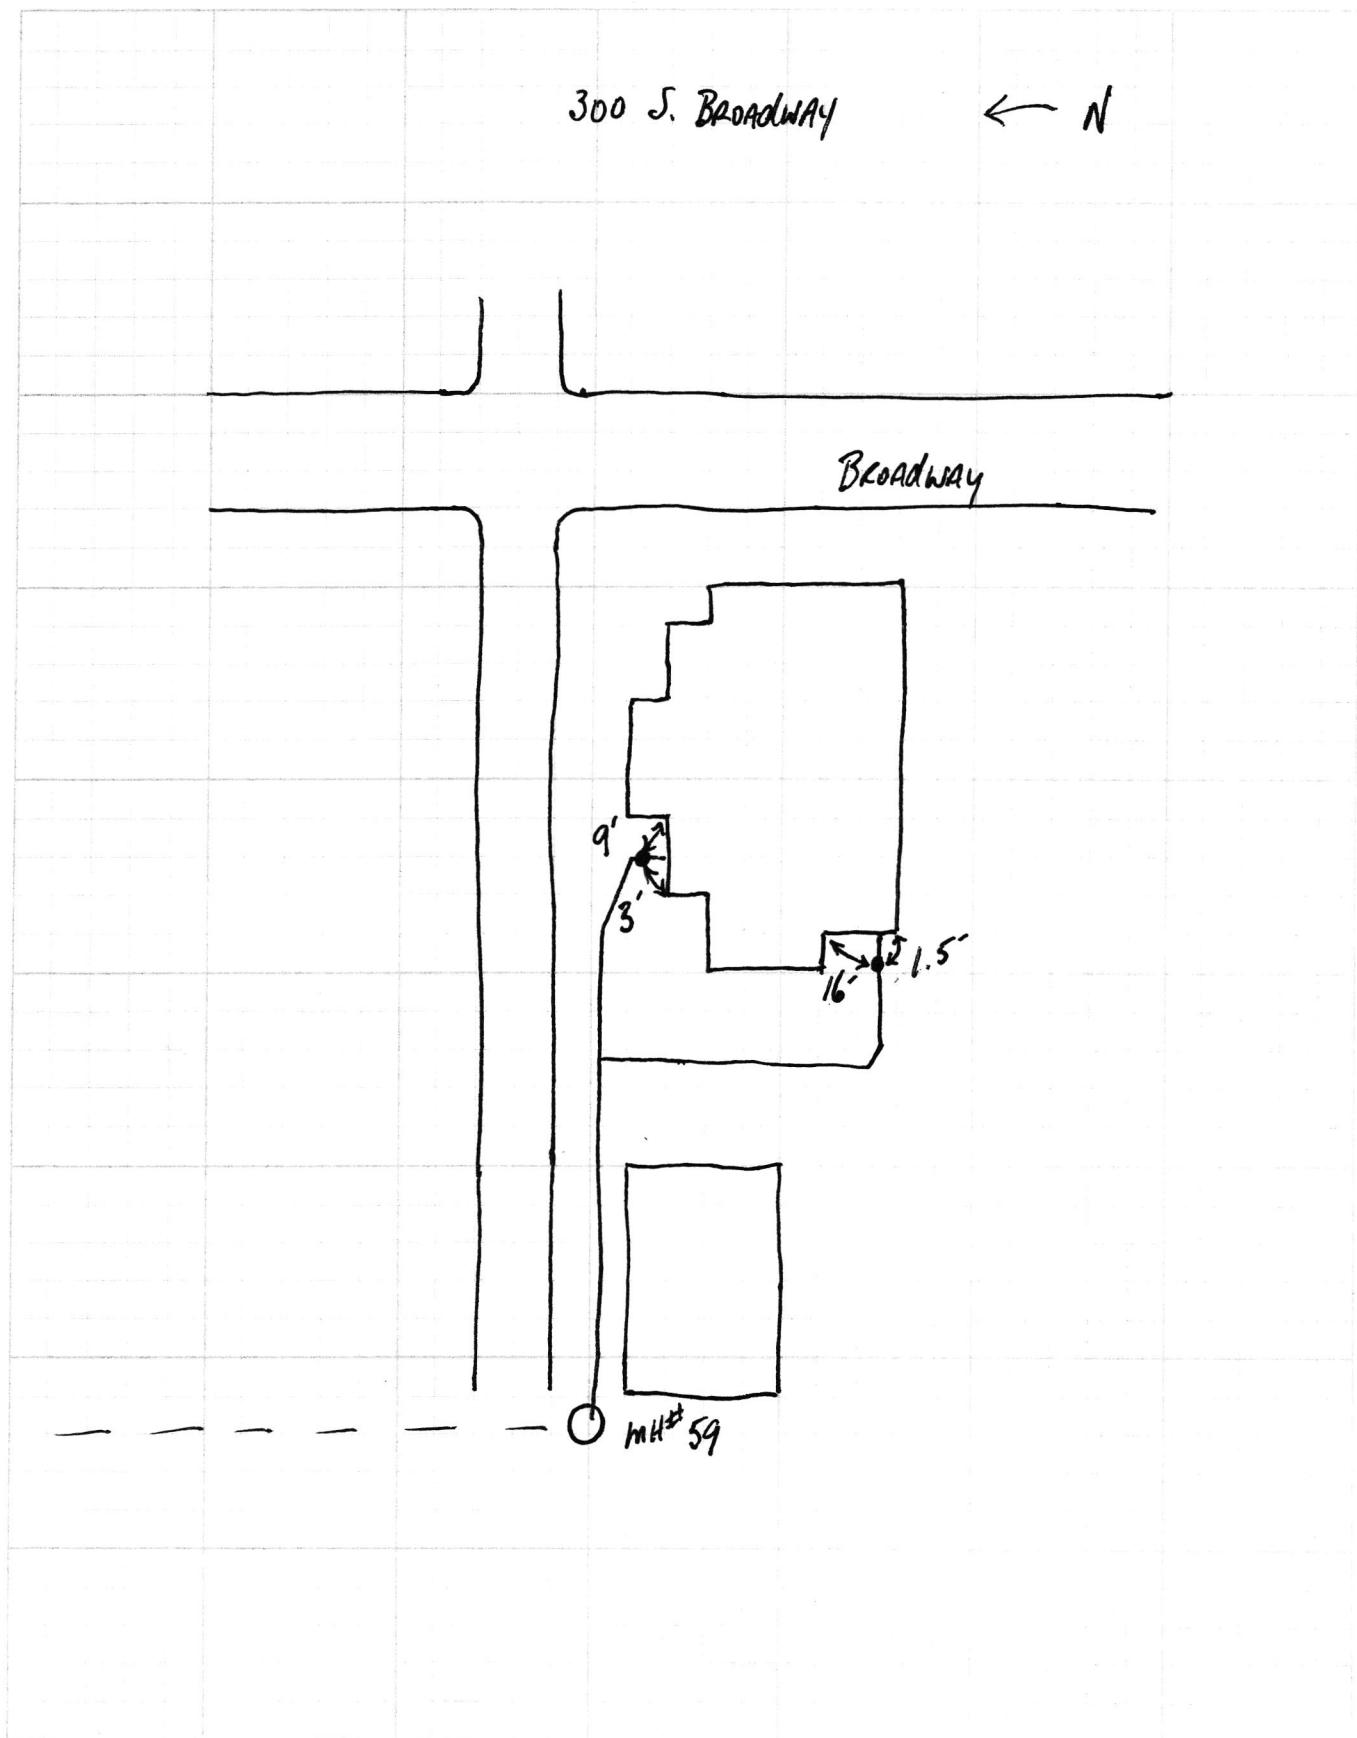

7.6.18

SRF Phase II

300 S Broadway

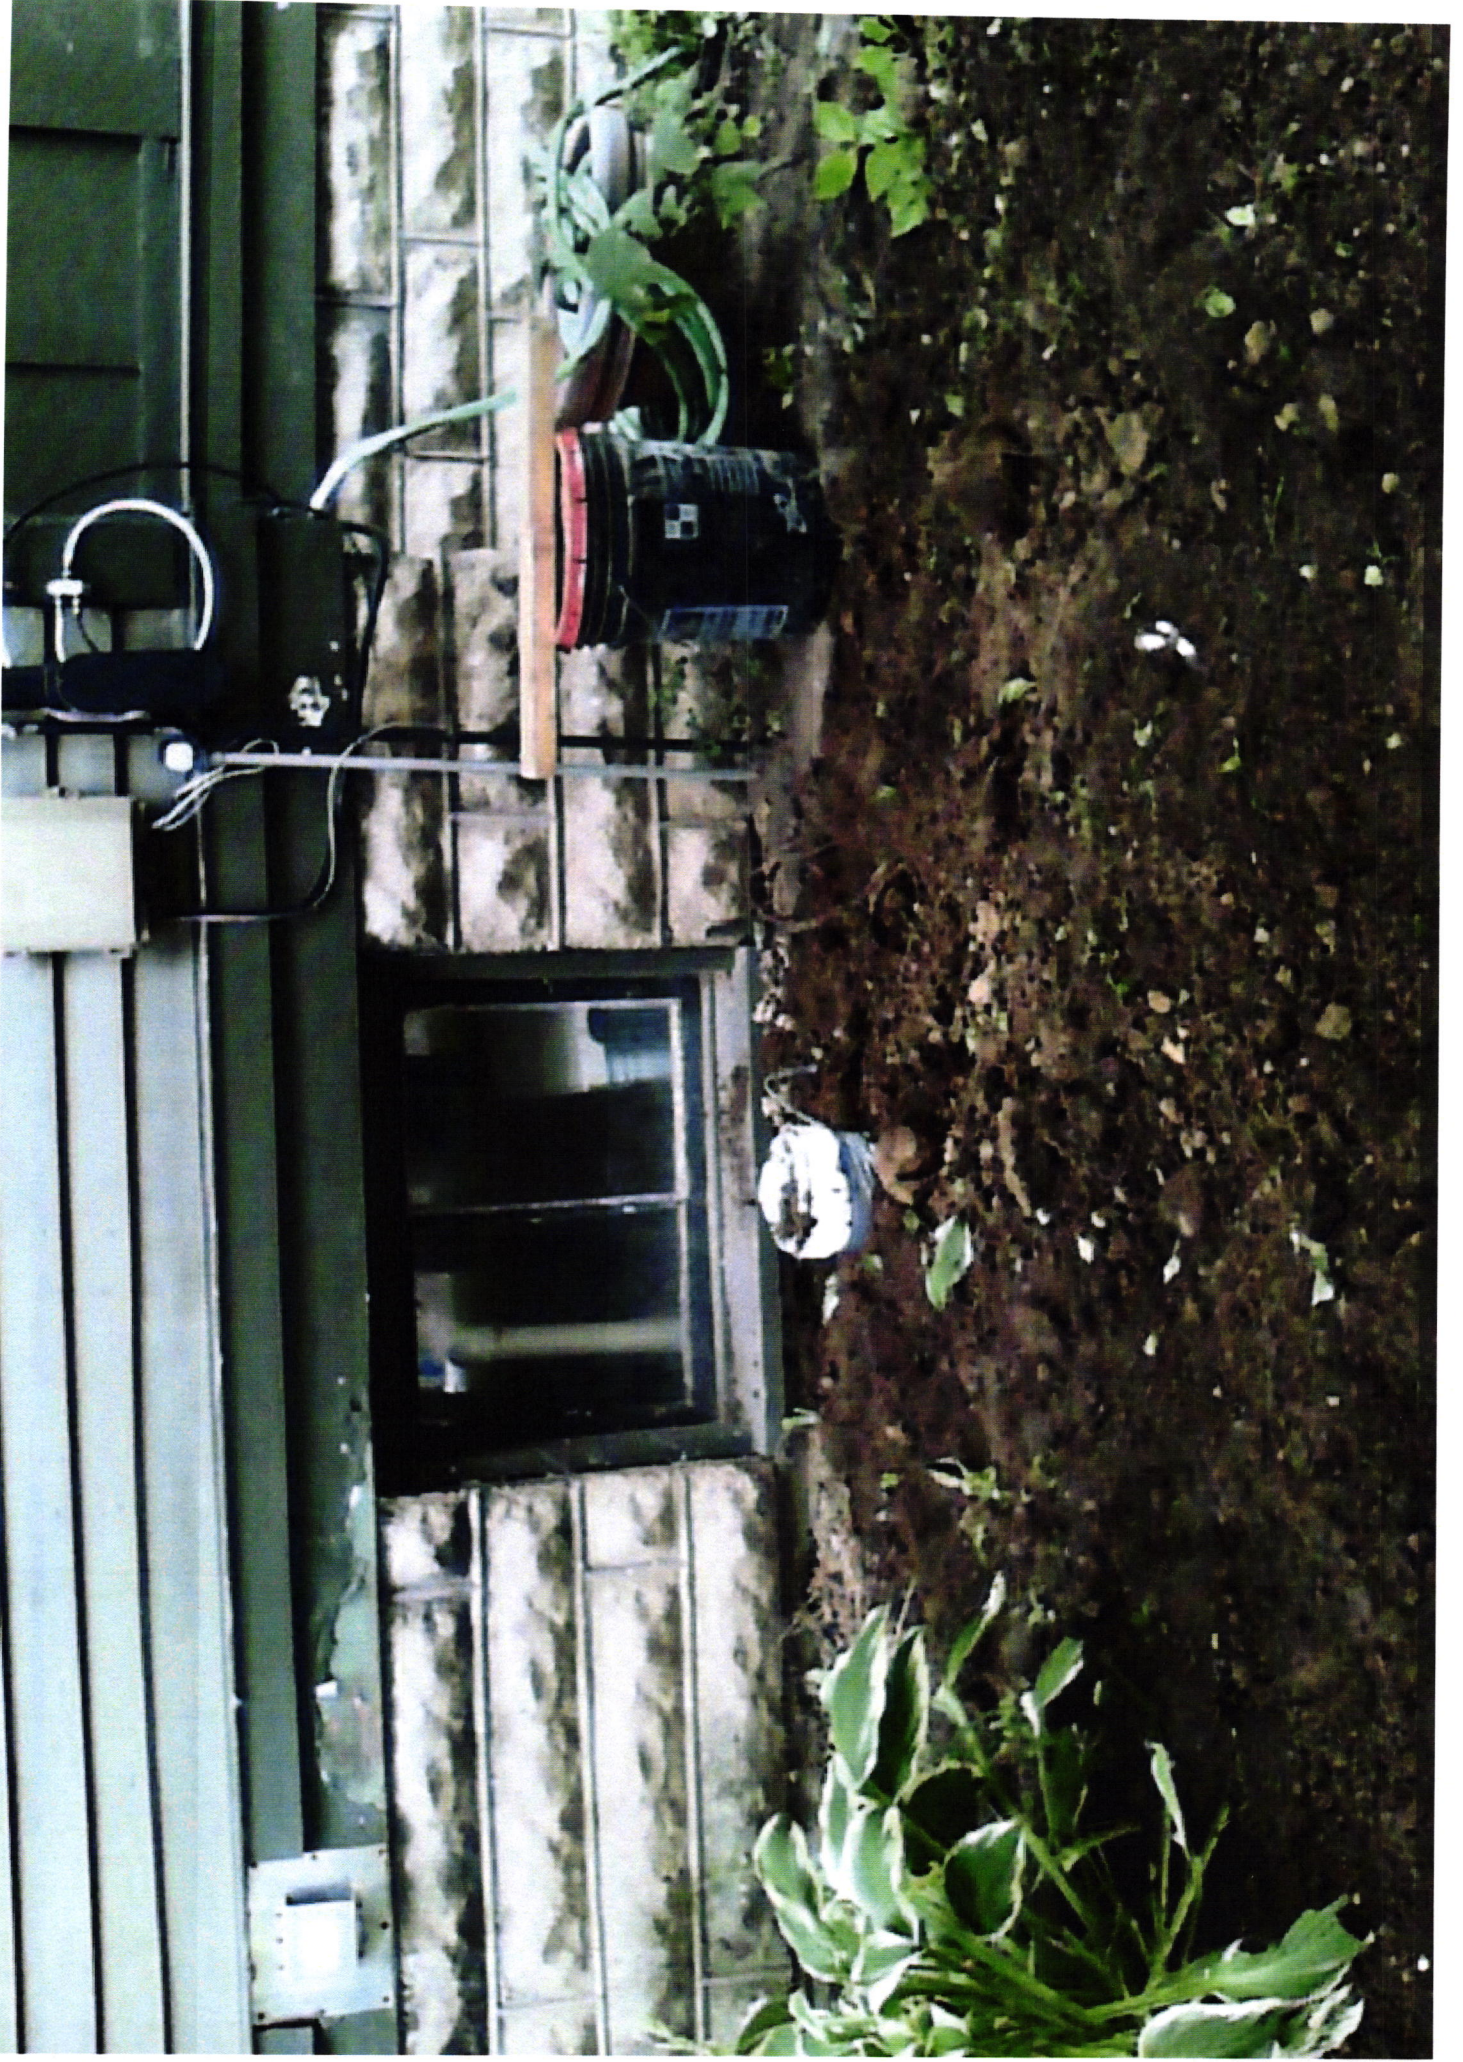

300 S Broadway

SRE Phase II

7.6.18

