


add order
on file

AGREEMENT FOR SANITARY SEWER SERVICE

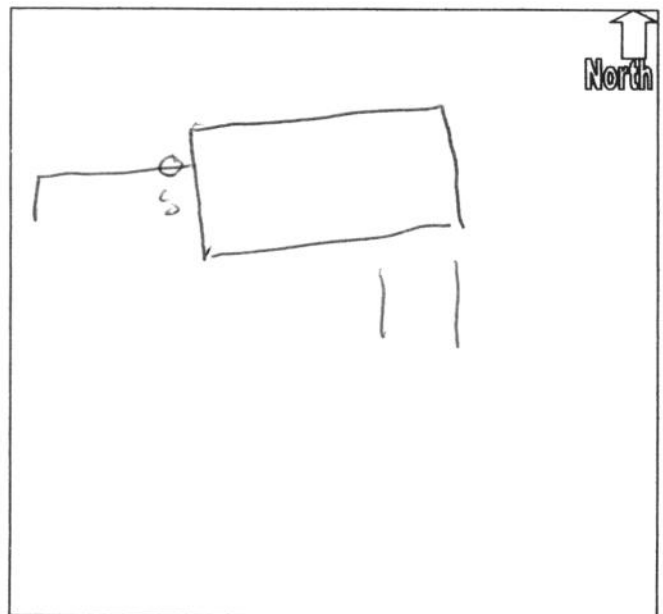

SUPPLEMENTAL UTILITY CONFLICT INFORMATION

N-2214

PROPERTY/STREET/ALLEY CROSSED

301 JEFFERY LANE

LOT

CITY PENDLETON

COUNTY MADISON

UTILITY LOCATE PERFORMED BY

BUSTAMANTE-BAYLESS

DATE

6-28-23


DOCUMENT SIZE/DEPTH OF SEWERS WHEN CROSSING WITH PROPOSED GAS PIPELINE.

	#1	#2	#3	#4	#5	#6
SEWER DIAMETER	"	"	"	"	"	"
SEWER DEPTH	"	"	"	"	"	"
GAS DEPTH	"	"	"	"	"	"

ACTUAL PROTECTIVE METHOD(S) AGAINST SEWER TRANSECTIONS (LIST ALL THAT APPLY):

GAS MAIN

GAS SVC

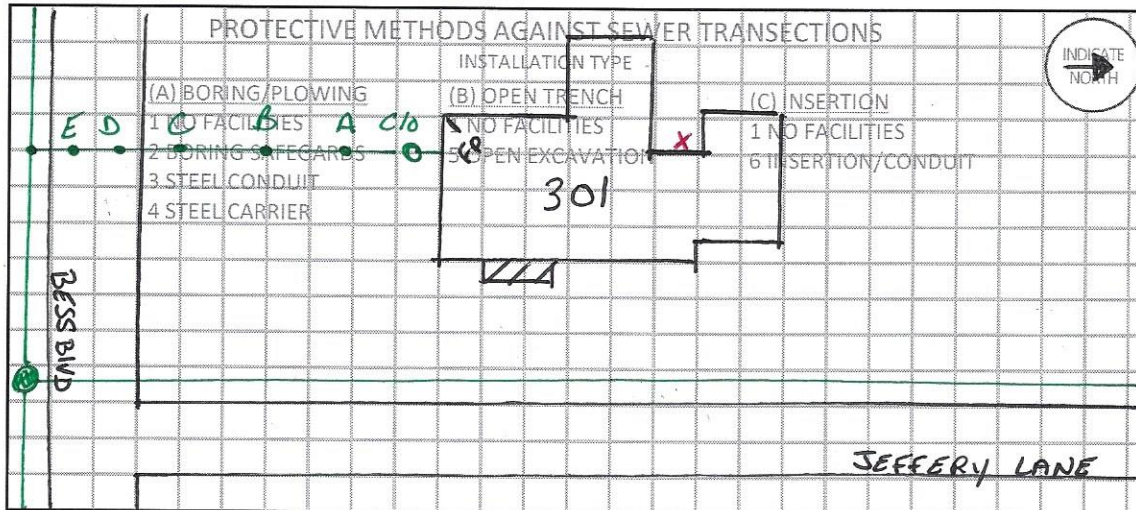

LOCATION OF SEWER FROM FIXED POINT

POINT	#FEET S DIR ORIGIN	#FEET E DIR ORIGIN	DEPTH (IN)
a	19 FT.	5 FT.	44"
b	31 FT.	5 FT.	43"
c	45 FT.	3 FT.	78"
d	56 FT.	3 FT.	89"
e	69 FT.	3 FT.	90"
f	FT.	FT.	"
g	FT.	FT.	"
h	FT.	FT.	"
i	FT.	FT.	"
j	FT.	FT.	"

BORE REVIEW INSPECTOR

COMPANY

FOREMAN/CREW LEAD

COMPANY

BORE OPERATOR

COMPANY

DATE OF BORE REVIEW

SERVICE RECORD SKETCH

MAIN LOCATION

FT.

SERVICE TAP DIMENSIONS:

X

Y

Z

CURRENT TOTAL LENGTH OF ACTIVE SERVICE

SUPPLEMENTAL DIMENSIONS:

A

B

C

D

E

F

LENGTH OF TEST PIPE

SERVICE TEST PRESSURE

PSIG

TEST DURATION

TEST PERFORMED BY

COMPANY NAME

DATE

NOTES:

CONSTRUCTED BY

COMPANY NAME

EMP. NO.

DATE

INSPECTED BY

COMPANY NAME

EMP. NO.

DATE

SUPERVISOR CARD REVIEW

DATE