



FALL CREEK REGIONAL WASTE DISTRICT

9378 S. 650 West PO Box 59
Pendleton, IN 46064-0059 778-7544

21-01880.00

Nº 2188

APPLICATION FOR SEWER PERMIT

Date 4-5-95

Permit Void 90 days from Date of Issuance

Owner Name Advas Prichard Prichard

Property Address 301 Meridian

Lot # _____ P.O. Box _____

Town Ingalls, IN Zip Code 46048

Phone _____ City Water X Well _____

\$ 2700.00 Tap on Fee ~~paid~~ } pay agreement-ck
\$ 25.00 Inspection fee ~~paid~~

Application is hereby made for connection to the Fall Creek Regional Waste District Sewer System for the above listed property - Permit Type: Residential X, Commercial _____, Industrial _____, or Governmental/Institutional _____. User Information _____.

All workmanship and materials shall conform to the standards of the District Ordinance as described in Ordinance 84-2 and 84-3 as amended. Acceptance and approval must be made by the District inspector or his duly authorized representative before backfilling and final connection is made to the main sewer lines. Any violation of applicable regulations will cause all lines and appurtenances in violation to be removed and replaced at the owners expense.

The Fall Creek Regional Waste District is responsible for the inspection, approval of materials, and installation techniques only. All costs for materials and installation and any liabilities resulting from same is the sole responsibility of the property owner.

I have read and fully understand the above provisions and agree to comply by said provisions.

Advas Prichard
APPLICANT(S) SIGNATURE


INSPECTOR B

Date inspected 4-6-95 Approved ✓ Rejected _____

Reason for rejection _____

Date reinspected _____ Approved _____ Rejected _____

Notes:
Size Pipe 6 "
Type Pipe PVC
Basement Yes _____ No X
Sump Pump Yes _____ No X
Downspout to Ground Yes X No _____
Septic Tank Pumped & filled Yes _____ No X
Contractor A+A Backhoe
Special Conditions _____
Existing Home _____
New Construction ✓

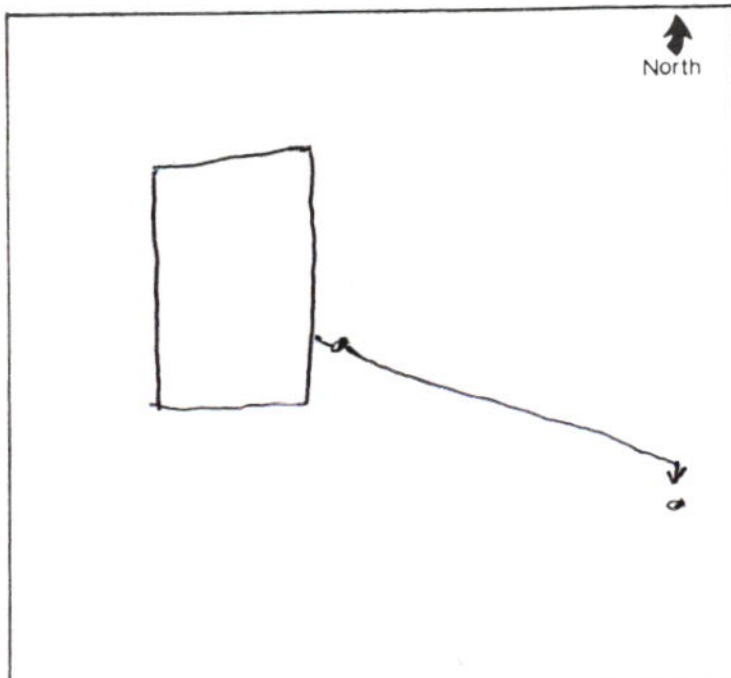

5014

SOUTHGATE HOMES 5-92

PH. 317-641-7018
5702 PENDLETON AVE.
ANDERSON, IN 46013

20-6/740

National City Bank
Anderson, Indiana 46016PAY
TO THE
ORDER OFJune 26 19 95
Fall Creek Regional Waste District\$2,425⁰⁰Two thousand four hundred twenty five and ⁰⁰/₁₀₀ DOLLARS

Tap Fee - Pritchard

THIS CHECK IS DELIVERED FOR PAYMENT ON THE ACCOUNTS LISTED

Pay R. Housh

MP

⑈005014⑈ ⑈074000065⑈