

FALL CREEK REGIONAL WASTE DISTRICT

9378 S 650 WEST, P.O. BOX 59, PENDLETON, IN 46064

765-778-7544

AGREEMENT FOR SANITARY SEWER SERVICE

This Agreement made and entered into this 2nd day of April, 2001, between FALL CREEK REGIONAL WASTE DISTRICT ("District") and James Schmitt ("Applicant") regarding the provision of sanitary sewer service, and the assignment of capacity in, and connection to, the District's facilities for the premises located at 301 Old SR 132 W.

NOW THEREFORE, the parties, in consideration of the mutual promises set out in this Agreement, the receipt and sufficiency of which is hereby acknowledged, agree as follows:

1. The Applicant agrees that all workmanship and materials shall conform to all District ordinances and the District's construction standards. District must accept and approve all work and materials before backfilling and final connection is made to the sewer mains. Any violation of this provision will cause all lines and appurtenances in violation to be removed and replaced at the Applicant's expense.
2. The District shall have the right to enter upon the Applicant's premises at all reasonable times to inspect, repair, or replace any equipment used in connection with the District's service or which has an impact on said service.
3. The Applicant shall be responsible for all monthly user rates, capacity charges, and tap fees. The failure to pay any rate charge or fee may result in a lien against the property and/or the termination of service to the property, the cost of which will be borne by Applicant, including, but not limited to, all attorney's fees and collection costs.
4. The District shall not be responsible for any damages as a result of any failure to supply service unless said damages are due to default, neglect or culpability on the part of the District.
5. If there is an available sanitary sewer within three hundred (300) feet of the property line, the property owner shall be required to connect to the District's sanitary sewer system.
6. The Applicant and District agree that the provision of sanitary sewer service touches and concerns the property and the terms of this Agreement bind the District and Applicant and their heirs, executors, administrators, personal representatives, successors, agents, attorneys, assigns, designees, and transferees.

The parties hereto have read and fully understand the above provisions and agree to comply with said provisions.

FALL CREEK REGIONAL WASTE DISTRICT
Deborah L. Wilson
Signature

APPLICANT
James E. Schmitt
Signature

STATE OF INDIANA)
) SS:
COUNTY OF MADISON)

SUBSCRIBED and sworn to before me this 2nd day of April, 2001.


My Commission Expires:
2-20-2008

Signature Deborah L. Wilson
Printed Deborah L. Wilson
Notary Public
Resident of Madison County

INSPECTOR Tim DATE INSPECTED 4-9-01 APPROVED ✓ REJECTED _____
REASON FOR REJECTION 4-16-01

DATE REINSPECTED _____ APPROVED _____ REJECTED _____

NOTES:
SIZE PIPE 6" TYPE PIPE SDR 35
BASEMENT YES ✓ NO _____
SUMP PUMP YES ✓ NO _____
DOWNSPOUT TO GROUND YES ✓ NO _____
SEPTIC TANK PUMPED & FILLED YES ✓ NO _____
CONTRACTOR SELF
SPECIAL CONDITIONS Not completed
EXISTING HOME ✓ DONE
NEW CONSTRUCTION _____

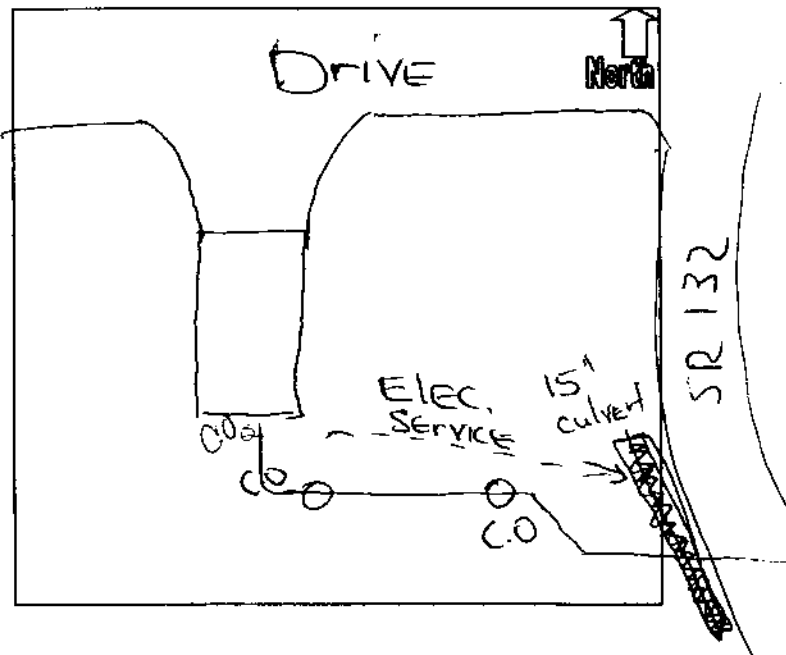

JAMES E. SCHMITT 11-90
JUDITH M. SCHMITT
 Ph 765-778-4342
 301 Old St Rd 132 W
 Pendleton, In 46064

0975

Date April 2, 2001 20-6740 308

Pay to the Order of FALLCREEK REGIONAL WASTE \$ 1872²⁵

ONE THOUSAND EIGHT HUNDRED SEVENTY TWO²⁵ ~~100~~ 25 Dollars

National City.
 National City Bank of Indiana
 Anderson, Indiana

For CAPACITY/TAP Fee James E Schmitt MP

⑆074000065⑆ 0975

© HARLAND PRESTIGE

JAMES E. SCHMITT
JUDITH M. SCHMITT
 PH. 765-778-4342
 301 OLD STATE RD 132 W.
 PENDLETON, IN 46064-8984

20-104-902
740 2323

Date 4-10-01

Pay to the order of Fall Creek Regional Waste \$ 27³⁵₇₀₀

Twenty seven and³⁵ 700 Dollars

KEYBANK NATIONAL ASSOCIATION
 ANDERSON, INDIANA 46015
 1-800-KEY2YOU

For Jessie M Schmitt MP

⑆074001048⑆ 2323

© CURRENT, INC. - TO RECORDER, 1-800-334-2344 - FANCHAMPT

PRESORTED
 FIRST CLASS MAIL
 U.S. POSTAGE PAID
 PENDLETON, IN. 46064
 PERMIT #9

SCHMITT, JAMES
 301 OLD SR 132 W

PENDLETON IN
 46064-8984

2323

ACCOUNT NUMBER

26-01570.00

SERVICE ADDRESS

301 OLD SR 132 W

BILLING DATE 3/23/01

PLEASE RETURN STUB WITH PAYMENT

TOTAL AMOUNT DUE	PAST DUE AMOUNT
27.35	27.35