


Gidw.



301 Pearl SRF Phase II

7.11.18

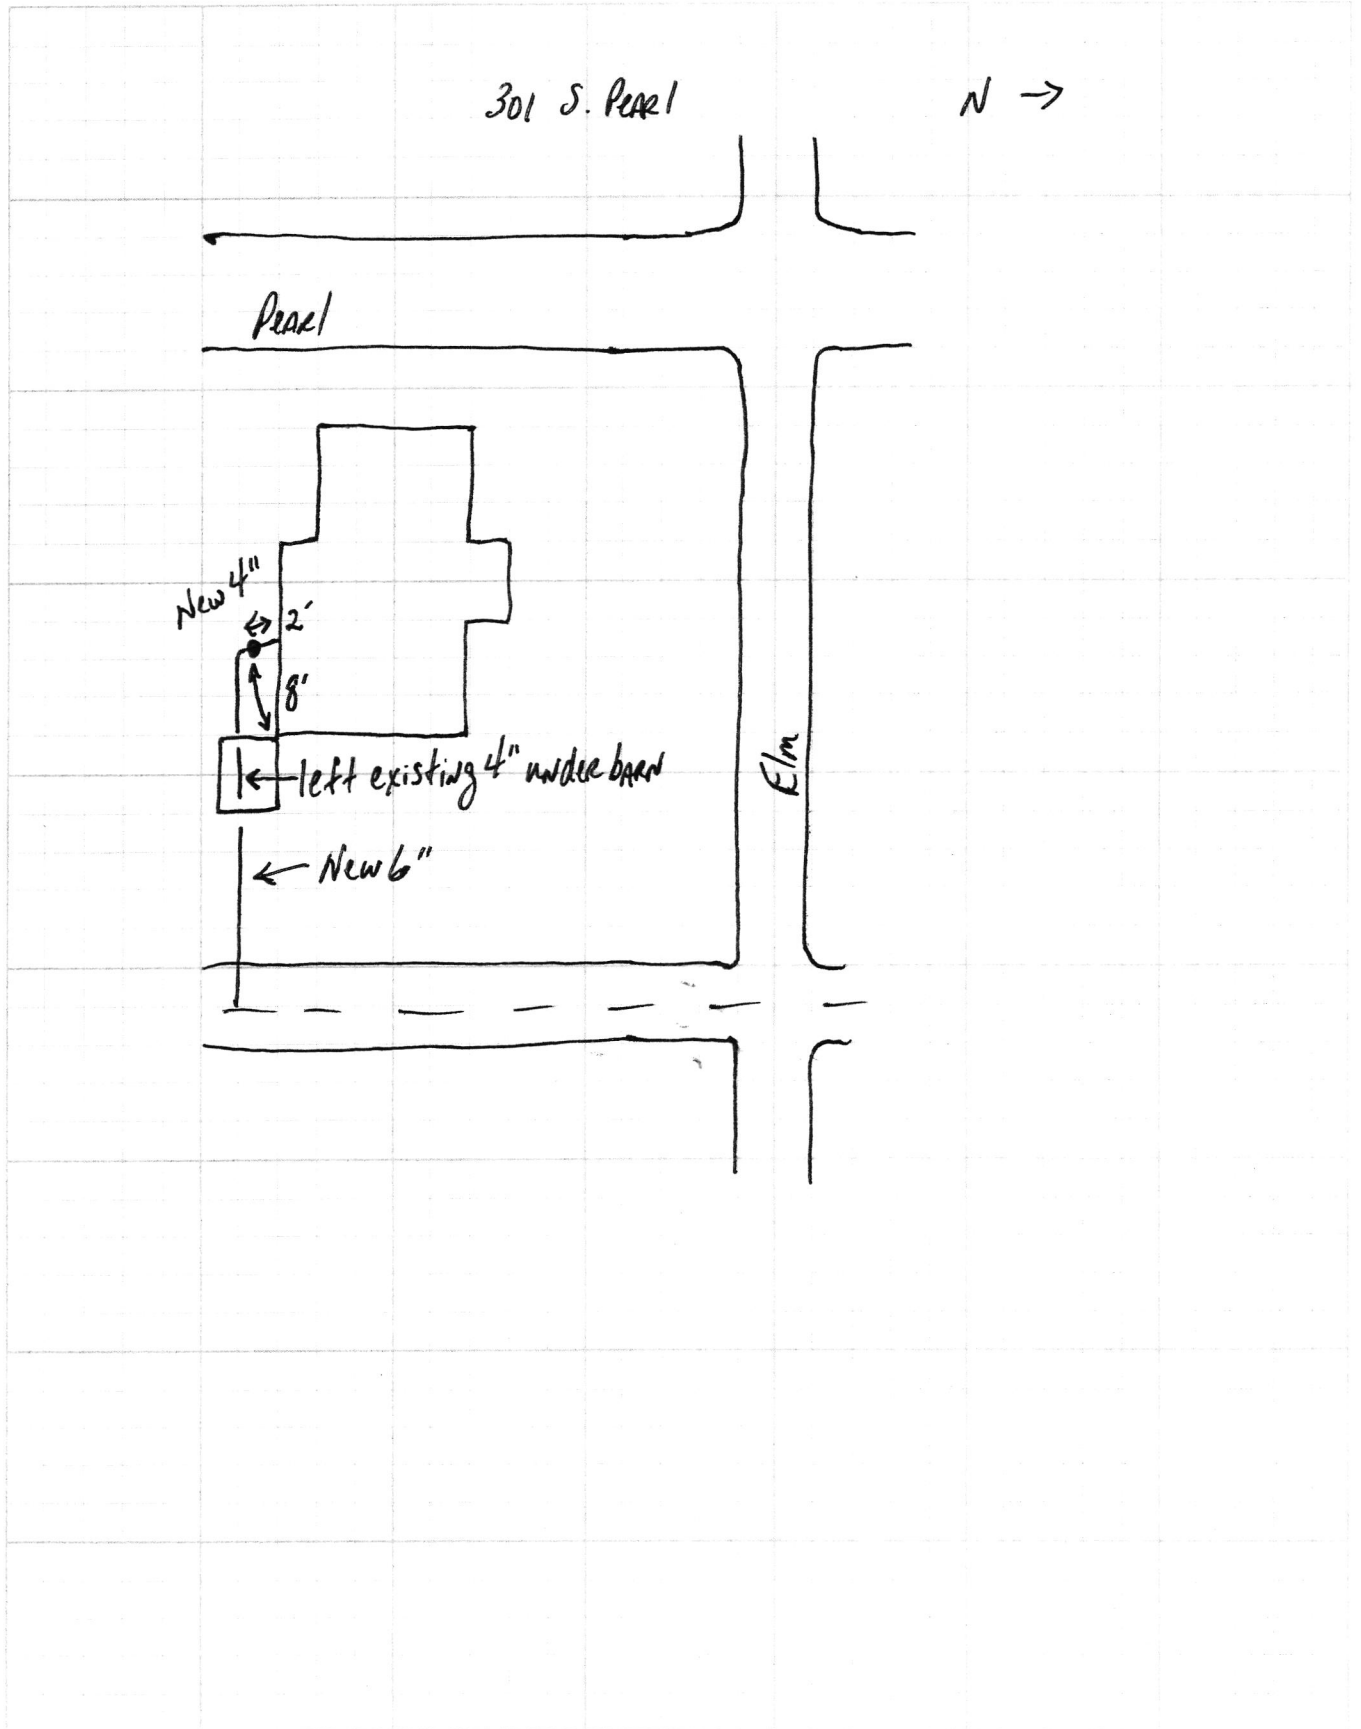