

Gidw.

PROJECT Phase II

SHEET _____ OF _____


SUBJECT _____

DATE 1-31-18

JOB NO. 4447

BY AHAS

301 W. Tile

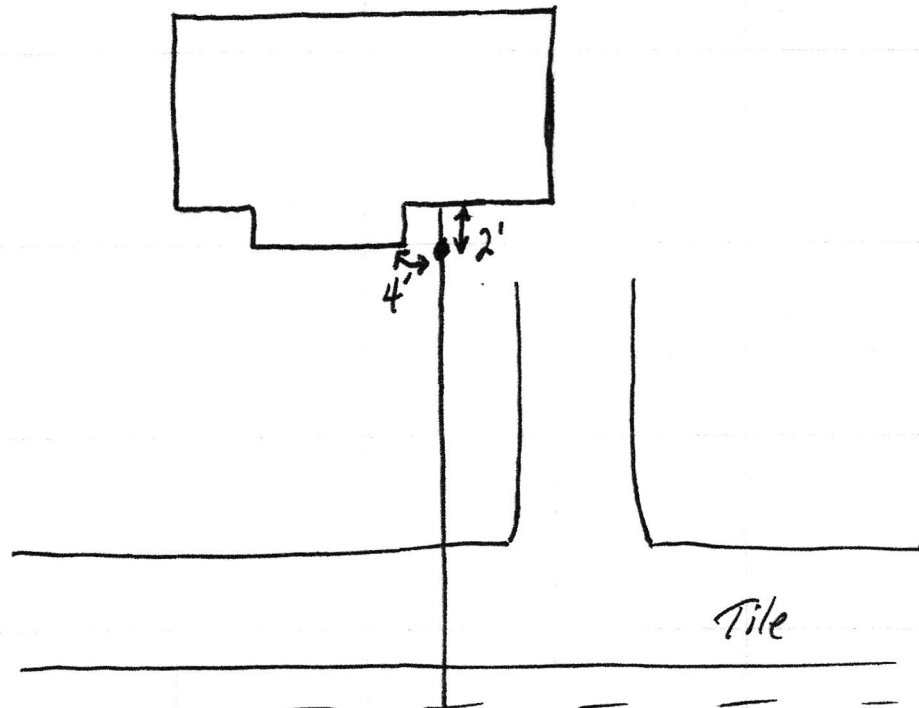

MH#
109
0—

301 W Tile

SRP Phase II

