

Gidw.

PROJECT Phase II

SHEET _____ OF _____


SUBJECT _____

DATE 2-5-18

JOB NO. 4447

BY Atlas

301 W. Taylor

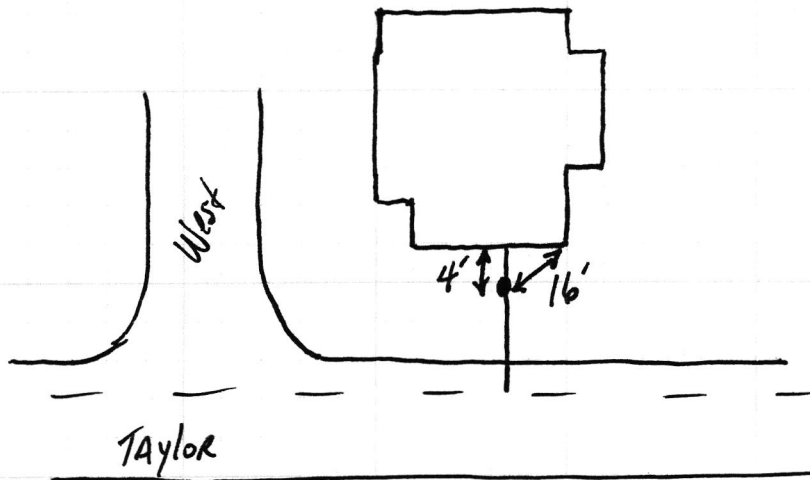

301 W Taylor

SRF Phase II

