
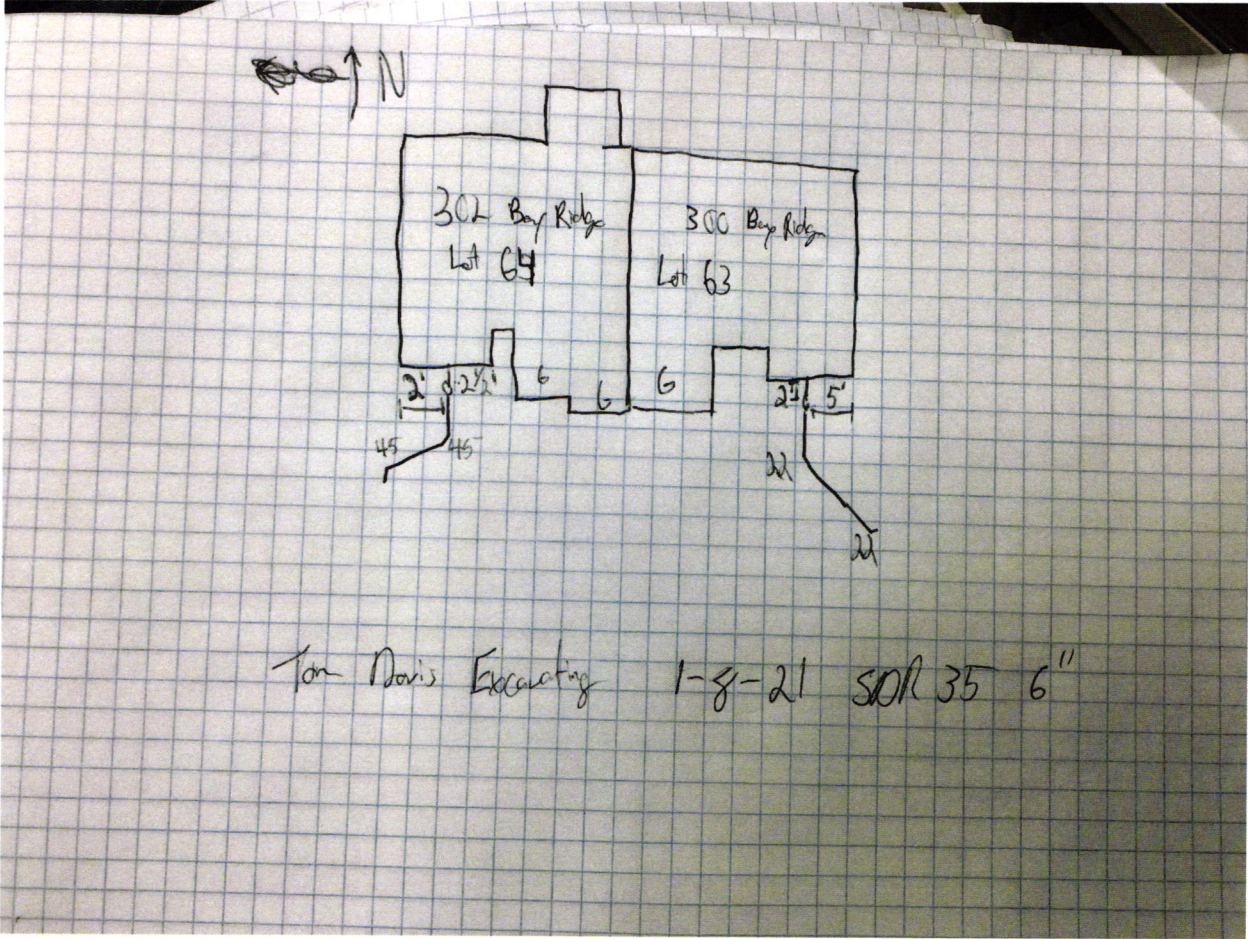


North 

Drawing  
+  
2 pictures  
attached



















**MUSTIN BUILDERS, INC.**  
810 CENTRAL AVENUE  
ANDERSON, IN 46012  
PH. 765-644-8502

**STAR**  
Financial Bank  
PO Box 11409 • Fort Wayne, IN 46858-1409

400475

71-167/749

*Eight Thousand Three Hundred Twenty* <sup>00</sup>/<sub>100</sub>

DATE

*1-6-21*

CHECK NO.

*400475*

AMOUNT

*8,320.00*

PAY  
TO THE  
ORDER  
OF

*FERWD*

*[Signature]*  
AUTHORIZED SIGNATURE

MP

⑆ 01475⑆ ⑆074901672⑆

*Rec # 011503*