

PROJECT Phase II

SUBJECT _____


SHEET _____ OF _____

DATE 12-15-17

JOB NO. 4447

BY Atlas

302 S. Pendleton

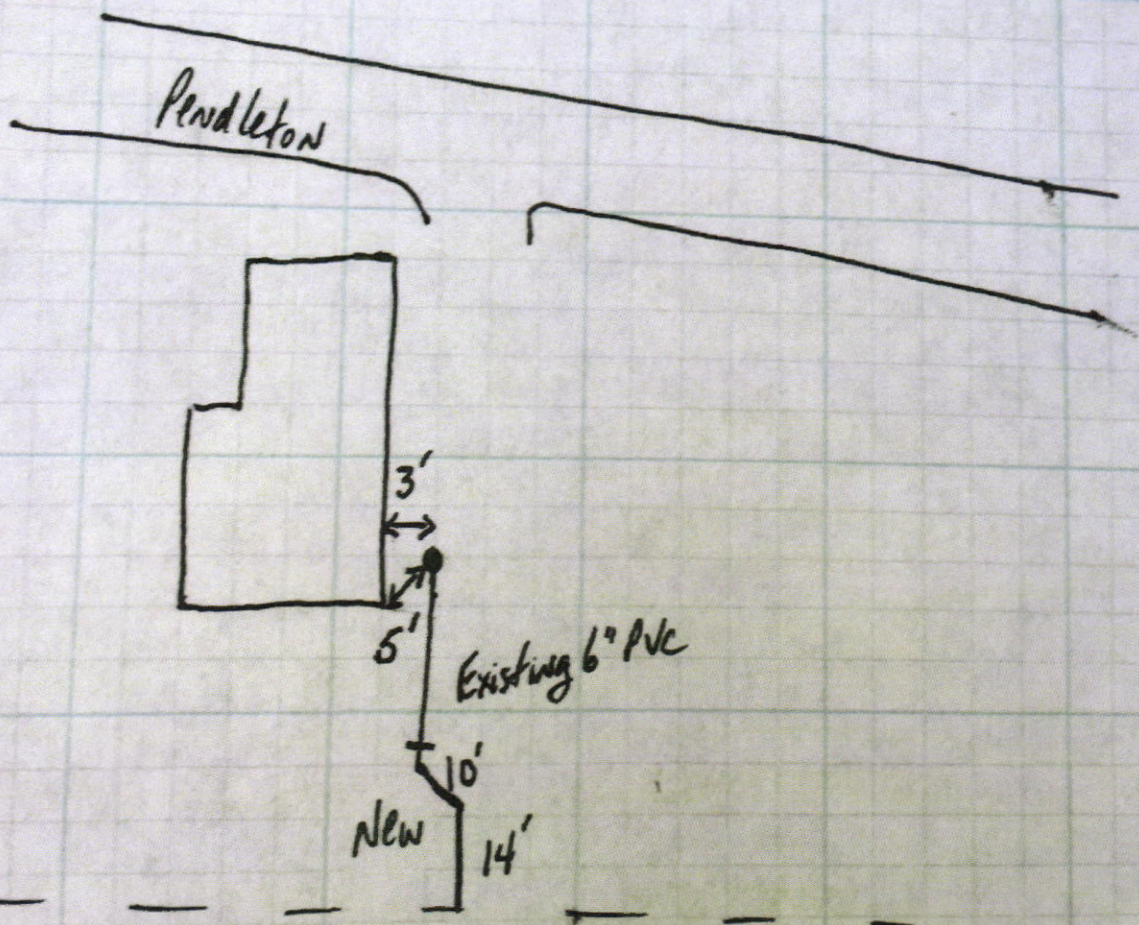

302 S Pendleton Ave

SRP Phase II

12.27.17

