


#6489

Agreement for Sanitary Sewer Service



Commissioner of the
Internal Revenue Service
Washington, D. C. 20548

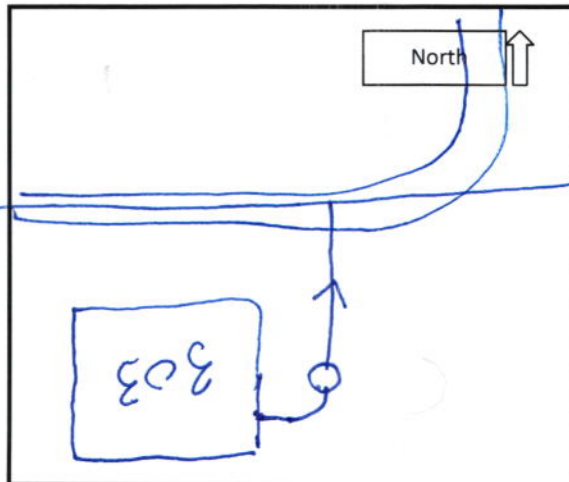

WARNING: THIS DOCUMENT HAS SECURITY FEATURES IN THE PAPER

LANCE L. TAYLOR
ANNE C. TAYLOR
10355 CO. RD. 400W
PENDLETON IN 46064

70-2189/719/059

Check No. 1714

Date 6/13/14

to the
order of

F.C.R.W.D.

\$ 5030.64

Five Thousand Thirty and 64/100

DOLLARS

PNC BANK, N.A. 071
INDIANAPOLIS IN

no 303 Laurel Grinder, Pit, and Fees.

Lance L. Taylor

⑆071921891⑆ 4616386026⑈ 1714