

Gidw.

PROJECT

Phase II

SHEET

OF

SUBJECT

DATE

7-5-18

JOB NO.

4447

BY

Atlas

303 S. Pearl


N →

Pearl

Elm

Alley

7' 15.5'

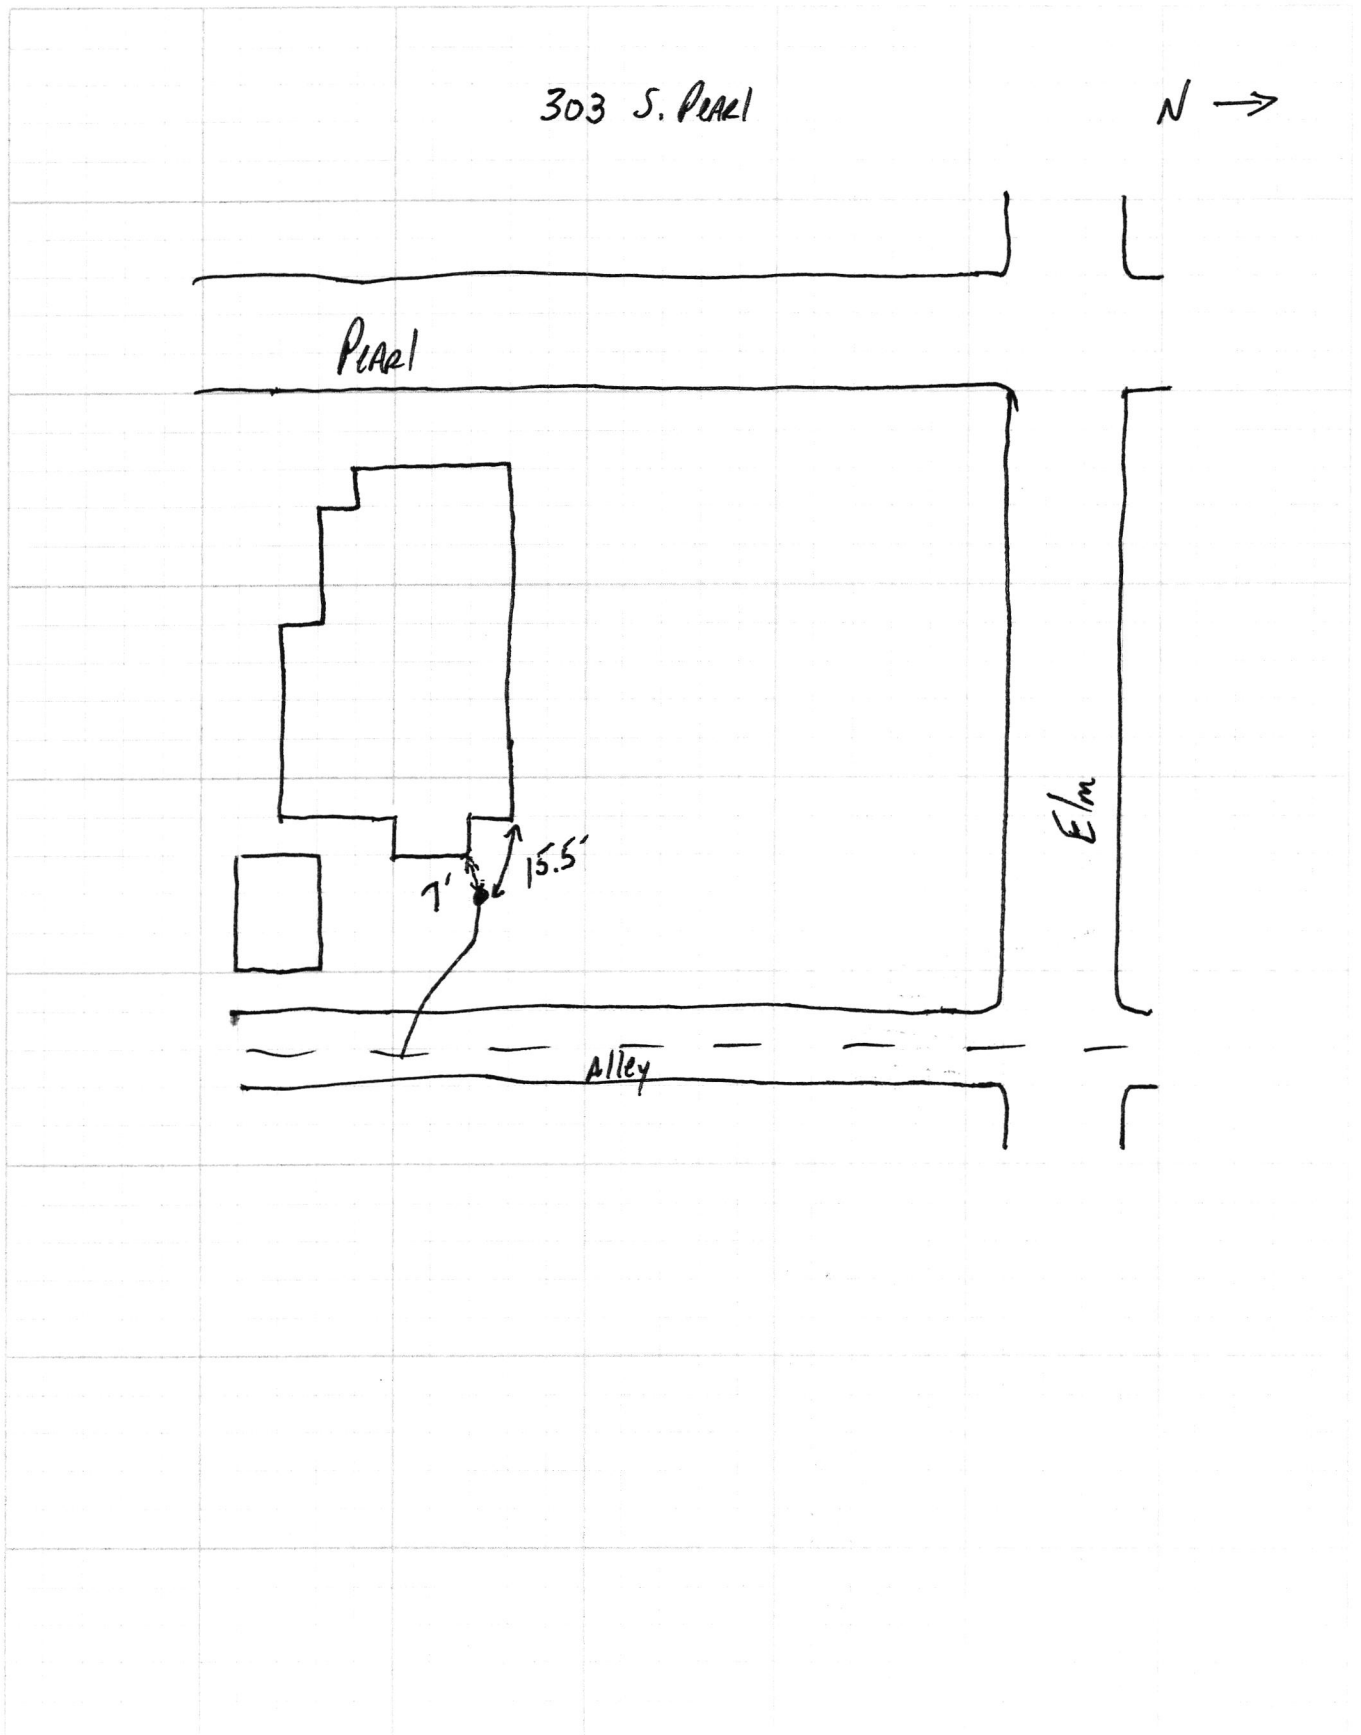

303 Pearl

SRF Phase II

7.6.18

