

Gidw.

PROJECT Phase II SHEET _____ OF _____


SUBJECT _____ DATE 7-20-18

JOB NO. 4447

BY Atlas

303 S. Broadway

N →

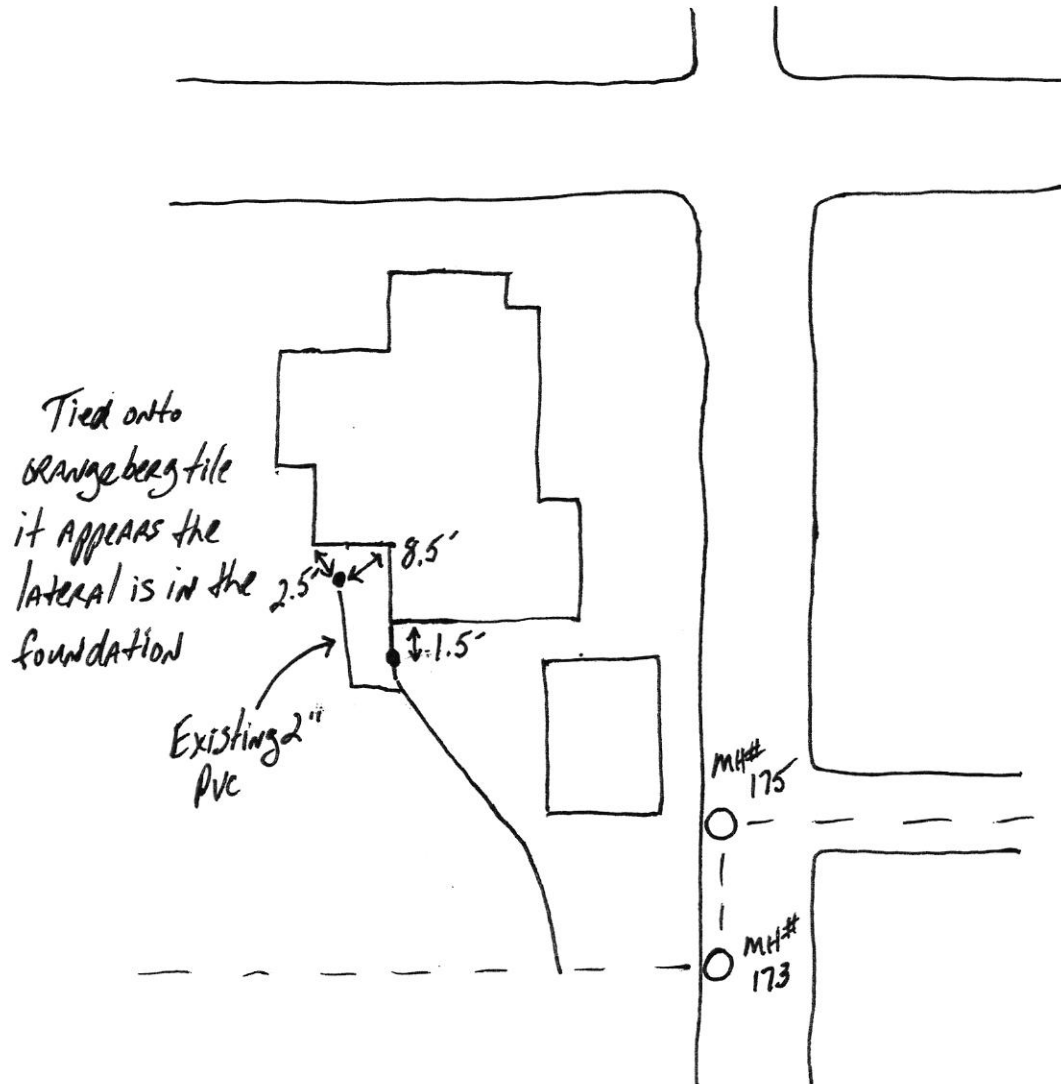

303 S Broadway

SF Phase II

7.30.18



303 S Broadway

SAT Phase II

7.30.18

