


G.R.W.

PROJECT Phase II SHEET _____ OF _____
SUBJECT _____ DATE 4-23-18
JOB NO. 4447
BY Atlas

303 W. State

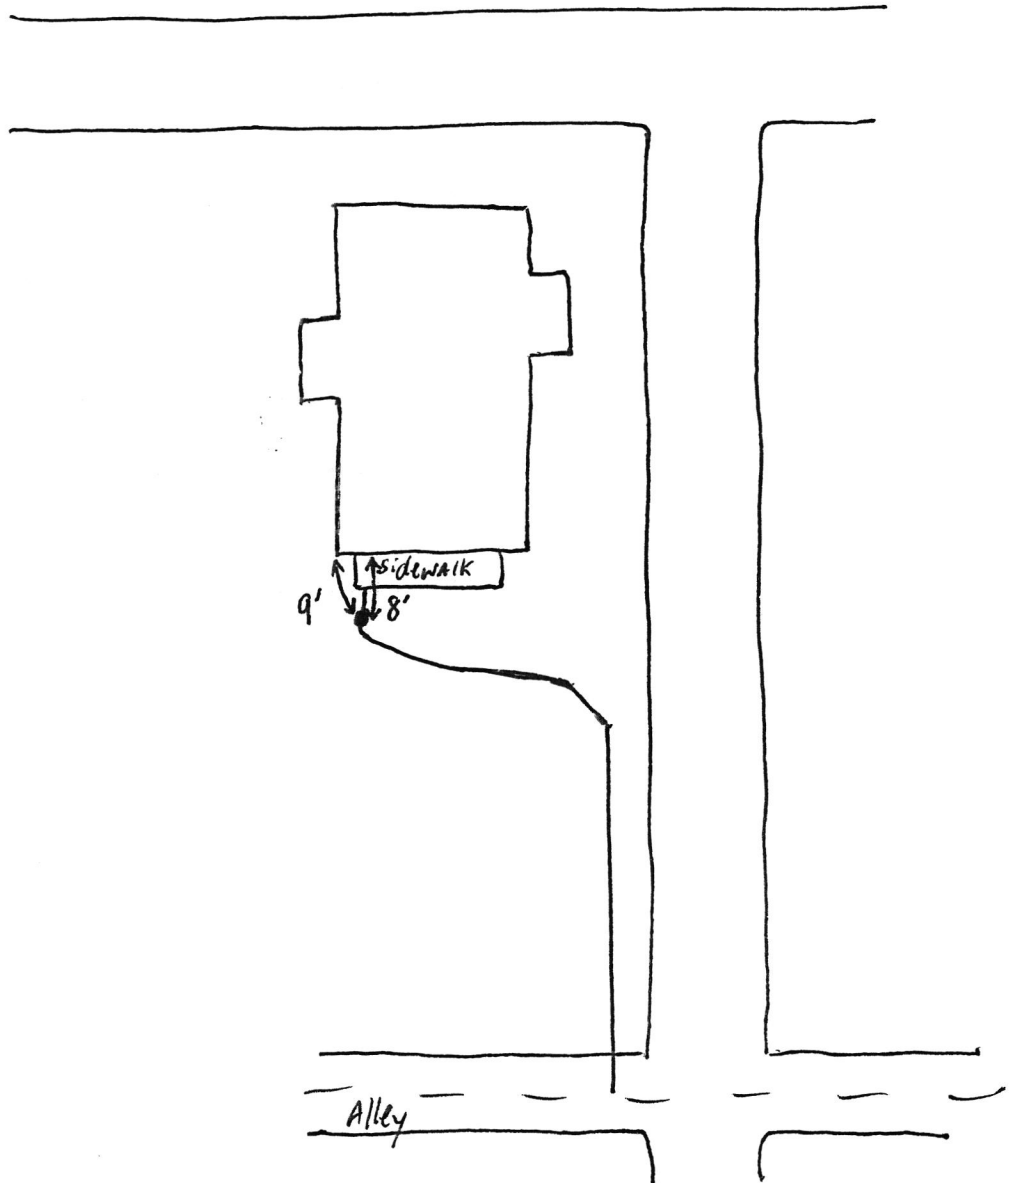

303 W State

SRF
Phase II

4.24.18

