

Gidw.

PROJECT

Phase II

SHEET

OF

SUBJECT

DATE


7-13-18

JOB NO.

4447

BY

Atlas

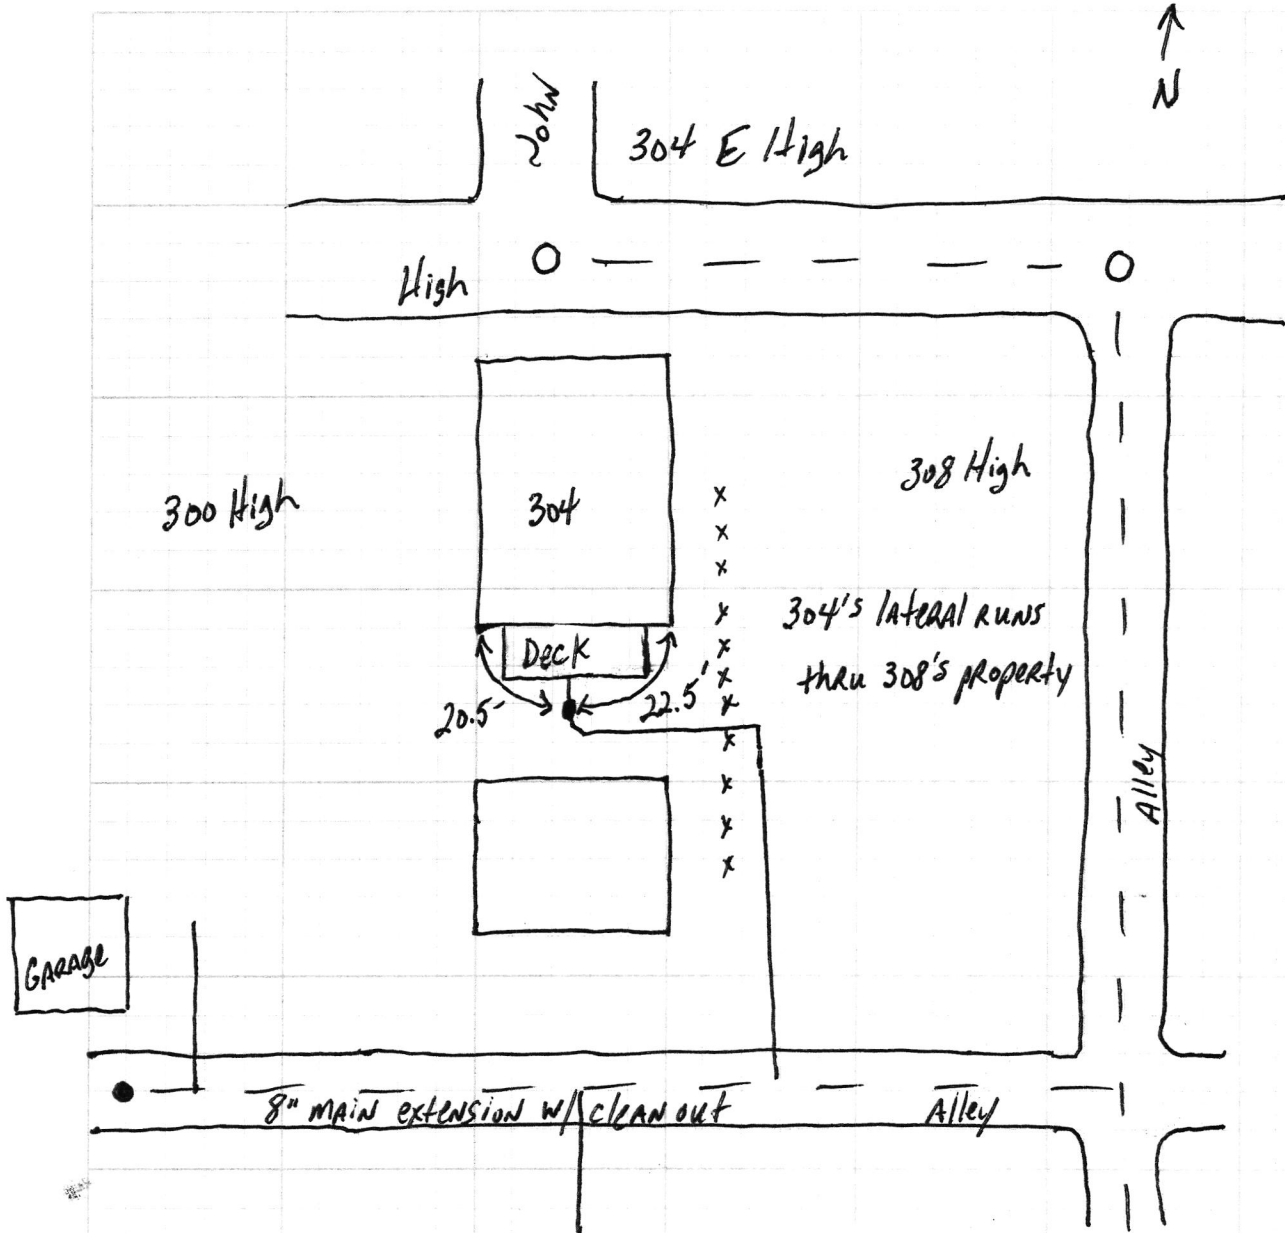

215 Pearl

300 High - 304 High - 215 Pearl
are in the 8" main extension

304 & High

SRT Phase II

7/18/18

