


4384

## AGREEMENT FOR SANITARY SEWER SERVICE

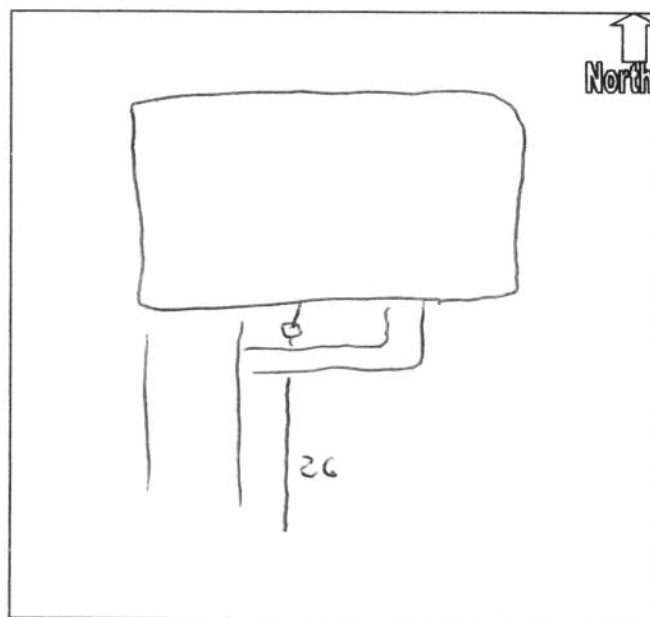

## SUPPLEMENTAL UTILITY CONFLICT INFORMATION

N-2214


PROPERTY/STREET/ALLEY CROSSED 305 JEFFERY LANE  
 LOT \_\_\_\_\_ CITY PEWDETON COUNTY MADISON  
 UTILITY LOCATE PERFORMED BY BUSTAMANTE-BAYLESS  
 DATE 6-26-23

DOCUMENT SIZE/DEPTH OF SEWERS WHEN CROSSING WITH PROPOSED GAS PIPELINE.

	#1	#2	#3	#4	#5	#6
SEWER DIAMETER	"	"	"	"	"	"
SEWER DEPTH	"	"	"	"	"	"
GAS DEPTH	"	"	"	"	"	"

ACTUAL PROTECTIVE METHOD(S) AGAINST SEWER TRANSECTIONS (LIST ALL THAT APPLY):

GAS MAIN \_\_\_\_\_ GAS SVC \_\_\_\_\_

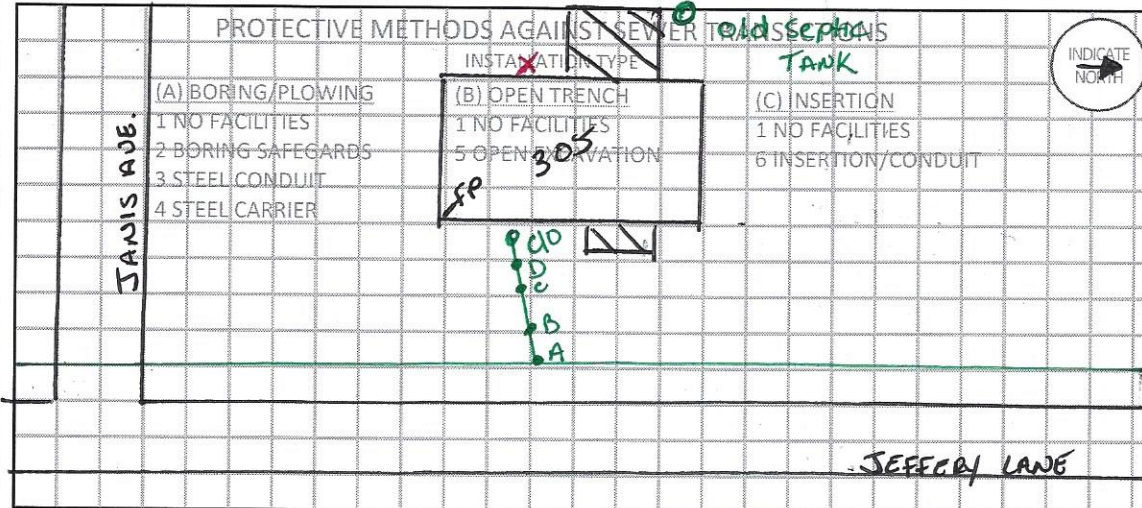

LOCATION OF SEWER FROM FIXED POINT

POINT	#FEET DIR ORIGIN	#FEET DIR ORIGIN	DEPTH (IN)
a	25 FT.	39 FT.	38"
b	25 FT.	28 FT.	35"
c	24 FT.	17 FT.	27"
d	24 FT.	6 FT.	23"
e	FT.	FT.	"
f	FT.	FT.	"
g	FT.	FT.	"
h	FT.	FT.	"
i	FT.	FT.	"
j	FT.	FT.	"

BORE REVIEW INSPECTOR \_\_\_\_\_ COMPANY \_\_\_\_\_ FOREMAN/CREW LEAD \_\_\_\_\_ COMPANY \_\_\_\_\_  
 BORE OPERATOR \_\_\_\_\_ COMPANY \_\_\_\_\_ DATE OF BORE REVIEW \_\_\_\_\_

## SERVICE RECORD SKETCH

MAIN LOCATION \_\_\_\_\_ FT. \_\_\_\_\_ SERVICE TAP DIMENSIONS: \_\_\_\_\_ X \_\_\_\_\_ Y \_\_\_\_\_ Z \_\_\_\_\_  
 CURRENT TOTAL LENGTH OF ACTIVE SERVICE \_\_\_\_\_ SUPPLEMENTAL DIMENSIONS: \_\_\_\_\_ A \_\_\_\_\_ B \_\_\_\_\_ C \_\_\_\_\_ D \_\_\_\_\_ E \_\_\_\_\_ F \_\_\_\_\_  
 LENGTH OF TEST PIPE \_\_\_\_\_ SERVICE TEST PRESSURE \_\_\_\_\_ PSIG TEST DURATION \_\_\_\_\_  
 TEST PERFORMED BY \_\_\_\_\_ COMPANY NAME \_\_\_\_\_ DATE \_\_\_\_\_

INDICATE NORTH

NOTES:

\_\_\_\_\_

CONSTRUCTED BY \_\_\_\_\_ COMPANY NAME \_\_\_\_\_ EMP. NO. \_\_\_\_\_ DATE \_\_\_\_\_  
 INSPECTED BY \_\_\_\_\_ COMPANY NAME \_\_\_\_\_ EMP. NO. \_\_\_\_\_ DATE \_\_\_\_\_

SUPERVISOR CARD REVIEW \_\_\_\_\_ DATE \_\_\_\_\_