


Gidw.

PROJECT Phase II SHEET _____ OF _____

SUBJECT _____ DATE 6-26-18

JOB NO. 4447

BY Atlas

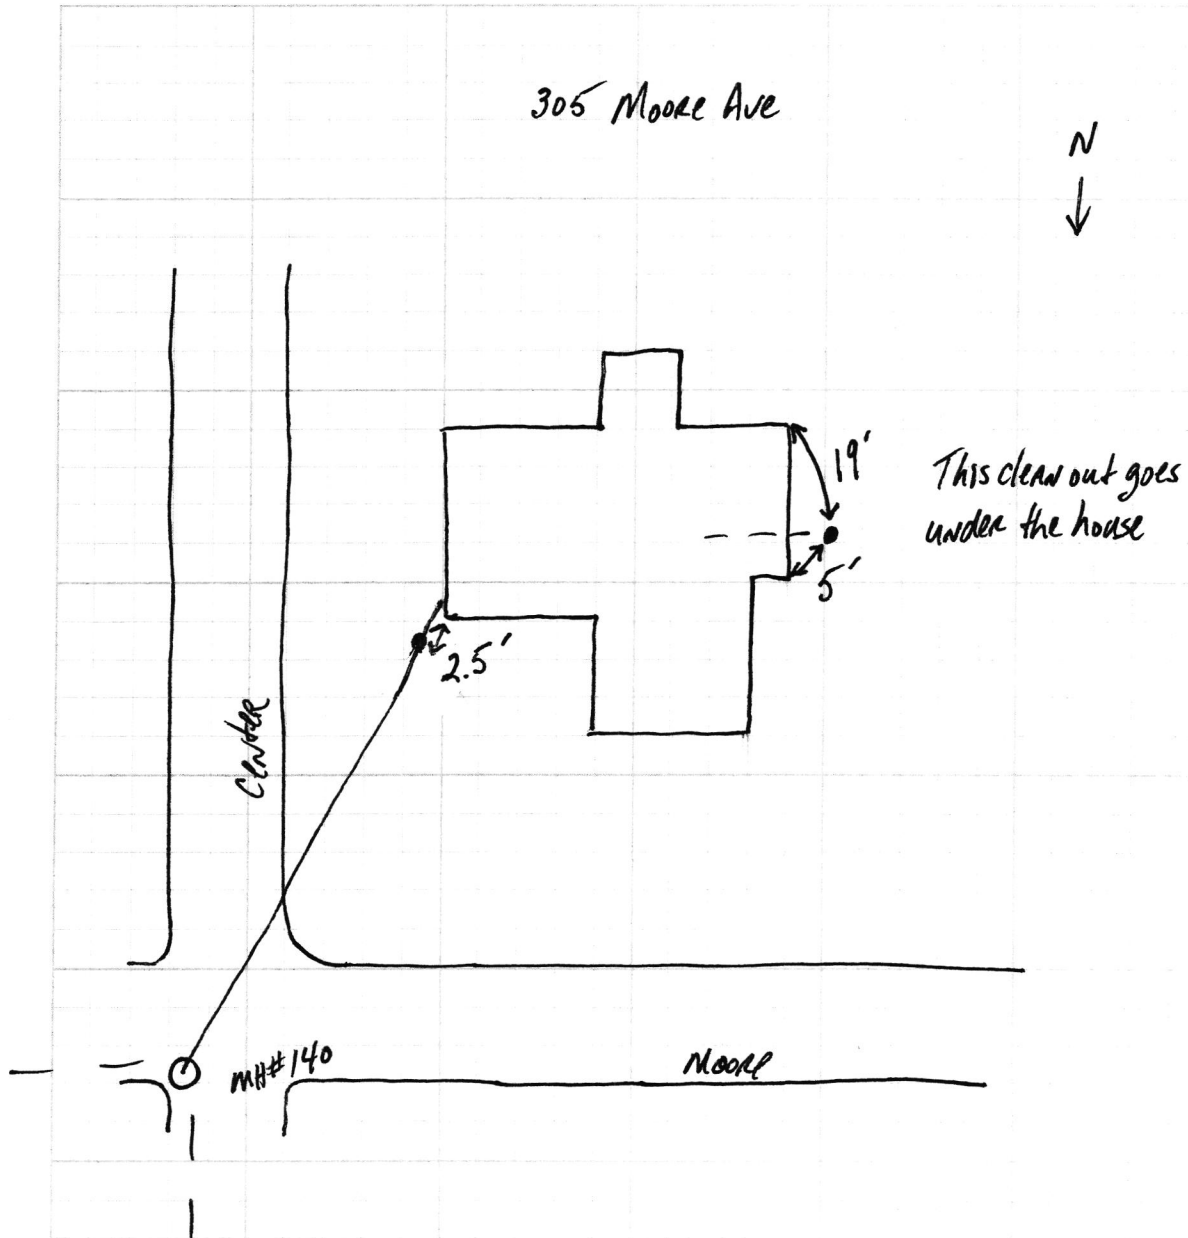

365 More

SRT Phase II

7.6.18



305 More

SPT Phase II

7.6.18

