


Gidw.

PROJECT Phase II SHEET _____ OF _____

SUBJECT _____ DATE 5-10-18

JOB NO. 4447

BY Atlas

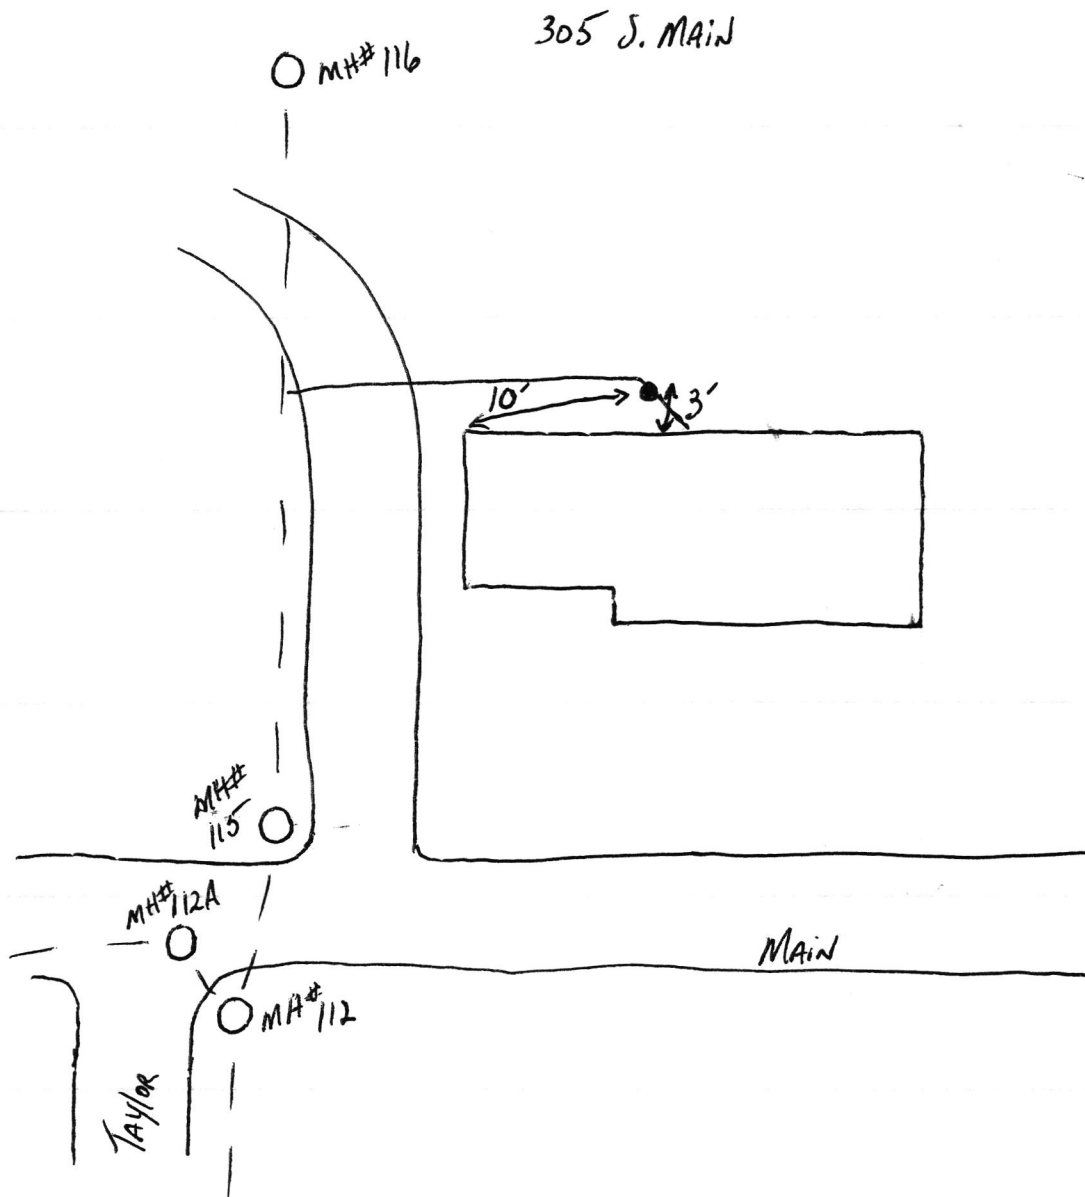

305 ^S Main
~~S Penetration~~

SPT Phase II

5.14.18











