

Fall Creek Regional Waste District
9378 S 650 W, P.O. Box 59, Pendleton, IN 46064
765-778-7544

#7791

Agreement for Sanitary Sewer Service

This Agreement made and entered into this 3 day of December, 2021, between Fall Creek Regional Waste District ("District") and D.R. Horton/Westport Homes ("Applicant") regarding the provision of sanitary sewer service, and the assignment of capacity in and connection to, the District's facilities for the premises located at Carrick Glen Lot 193.

Street Address: 305 Waterford Ln

Now therefore, the parties, in consideration of the mutual promises set out in this Agreement, the receipt and sufficiency of which is hereby acknowledged, agree as follows:

1. The Applicant agrees that all workmanship and materials shall conform to all District ordinances and the District's construction standards. District must accept and approve all work and materials before backfilling and final connection is made to the sewer mains. Any violation of this provision will cause all lines and appurtenances in violation to be removed and replaced at the Applicant's expense.
2. The District shall have the right to enter upon the Applicant's premises at all reasonable times to inspect, repair, or replace any equipment used in connection with the District's service or which has an impact on said service.
3. The Applicant shall be responsible for all monthly user rates, capacity charges, and tap fees. The failure to pay any rate charge or fee may result in a lien against the property and/or the termination of service to the property, the cost of which will be borne by Applicant, including, but not limited to, all attorney's fees and collection costs.
4. The District shall not be responsible for any damages as a result of any failure to supply service unless said damages are due to default, neglect or culpability on the part of the District.
5. If there is an available sanitary sewer within three hundred (300) feet of the property line, the property owner shall be required to connect to the District's sanitary sewer system.
6. The Applicant and District agree that the provision of sanitary sewer service touches and concerns the property and the terms of this Agreement bind the District and Applicant and their heirs, executors, administrators, personal representatives, successors, agents, attorneys, assigns, designees, and transferees.

The parties hereto have read and fully understand the above provisions and agree to comply with said provisions.

FALL CREEK REGIONAL WASTE DISTRICT
Rebecca Hunter
 Signature

APPLICANT
Signature

[illegible]

SUBSCRIBED and sworn to before me this _____ day of _____, 20_____

My Commission Expires: _____ Signature _____

Printed _____


Notary Public
Resident of _____ County


Inspector Don Date Inspected 5-4-22 Approved ✓ Rejected

Reason for Rejection _____


Date Reinspected _____ Approved _____ Rejected _____


Notes: _____
 Size Pipe 6" Type Pipe PVC 35
 Basement Yes No
 Sump Pump Yes No
 Downspout to Ground Yes No
 Septic Tank Pumped & Filled Yes No
 Contractor Wills Ex.
 Special Conditions 7/4/ER
 Existing Home _____
 New Construction ✓

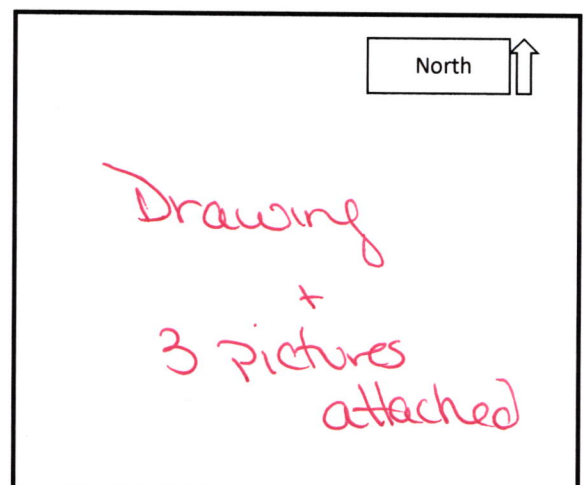

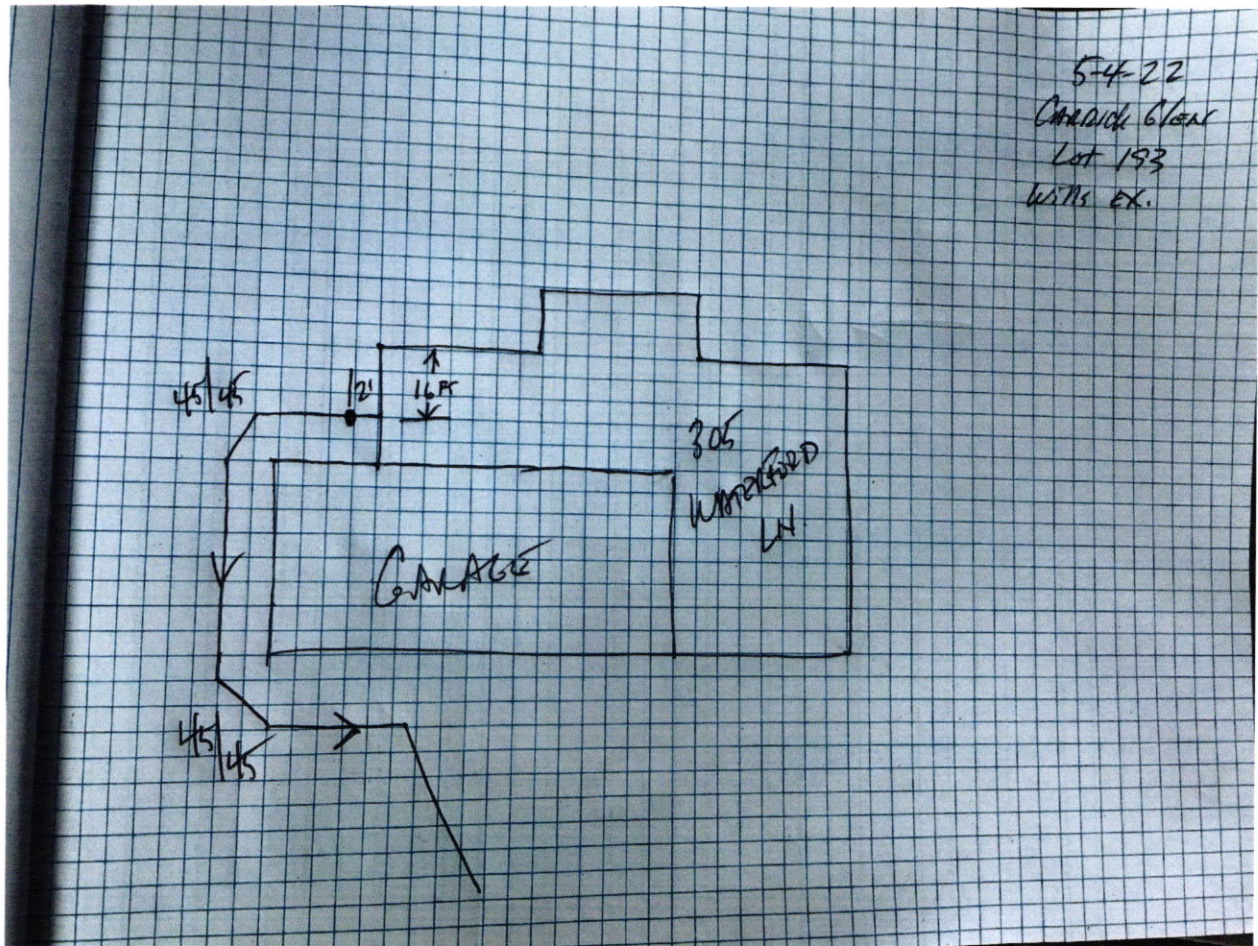



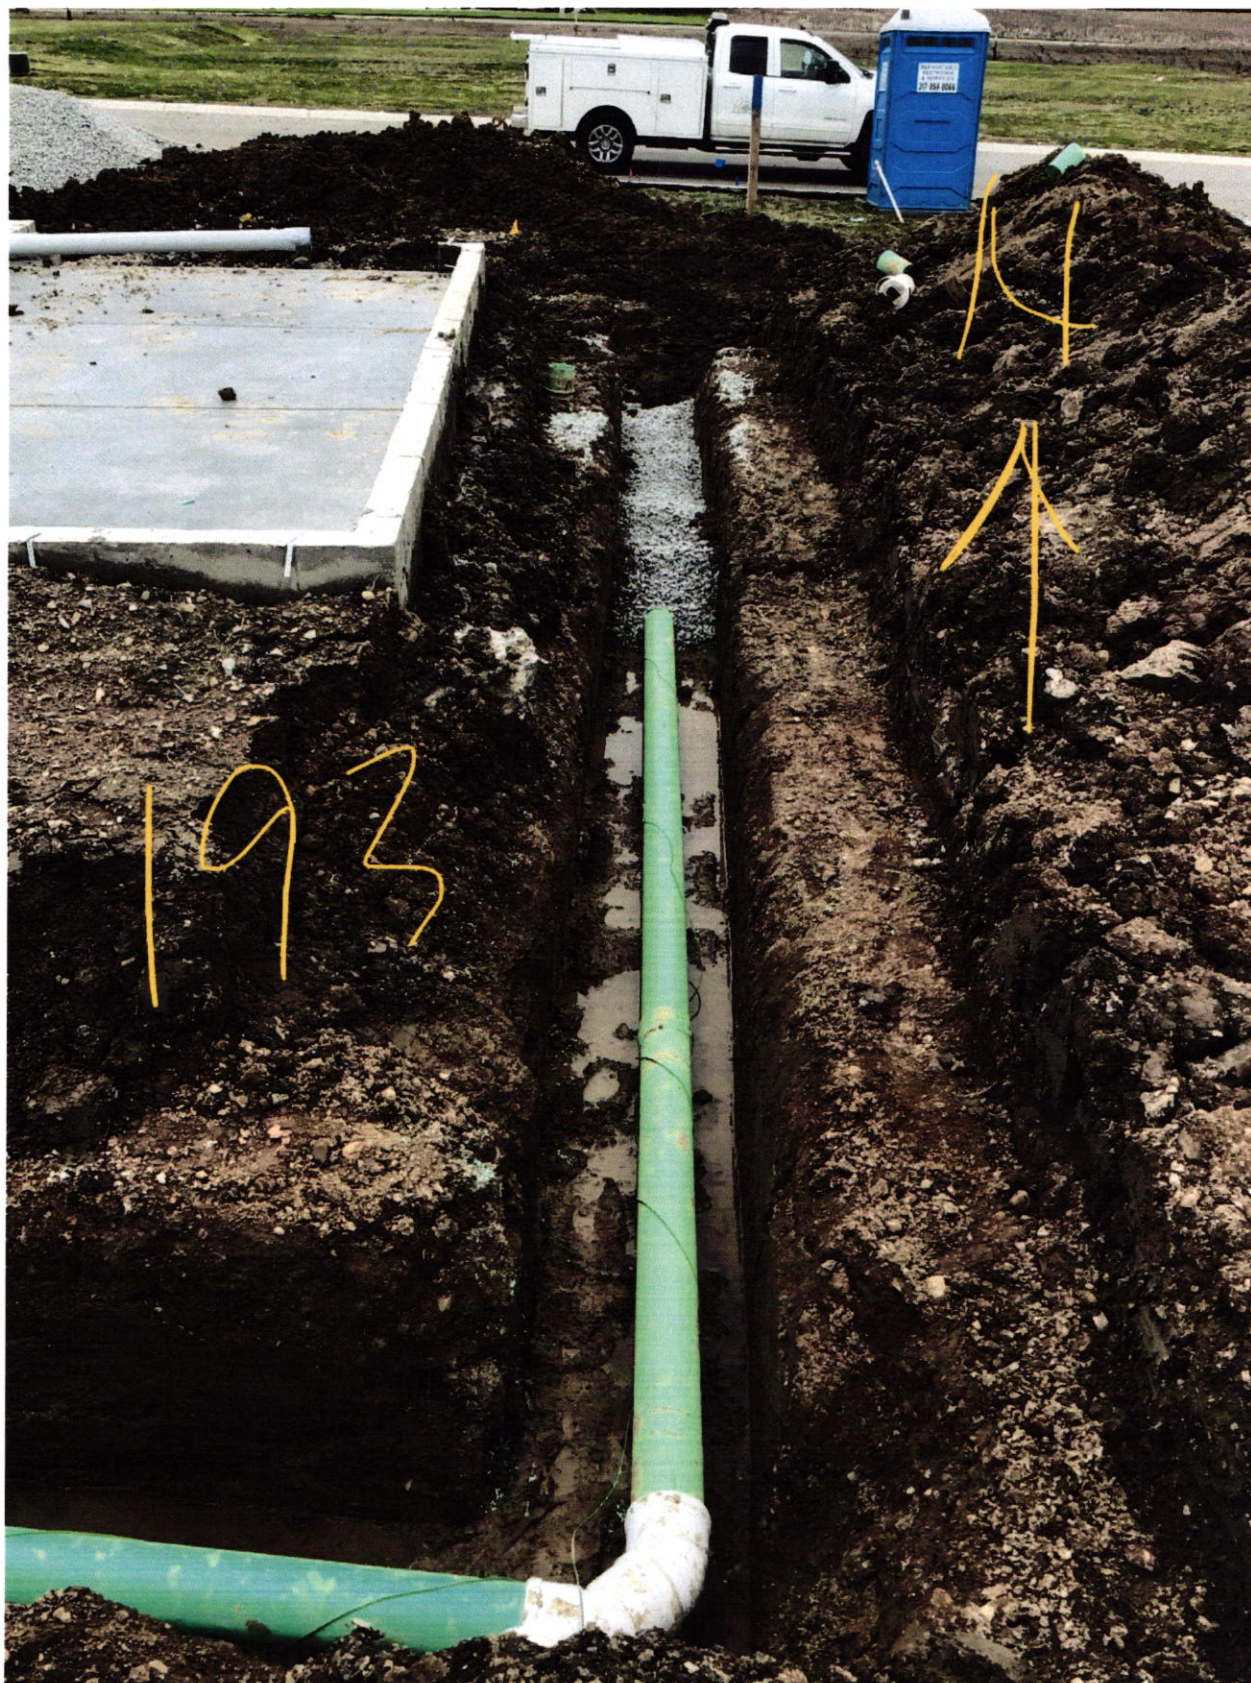

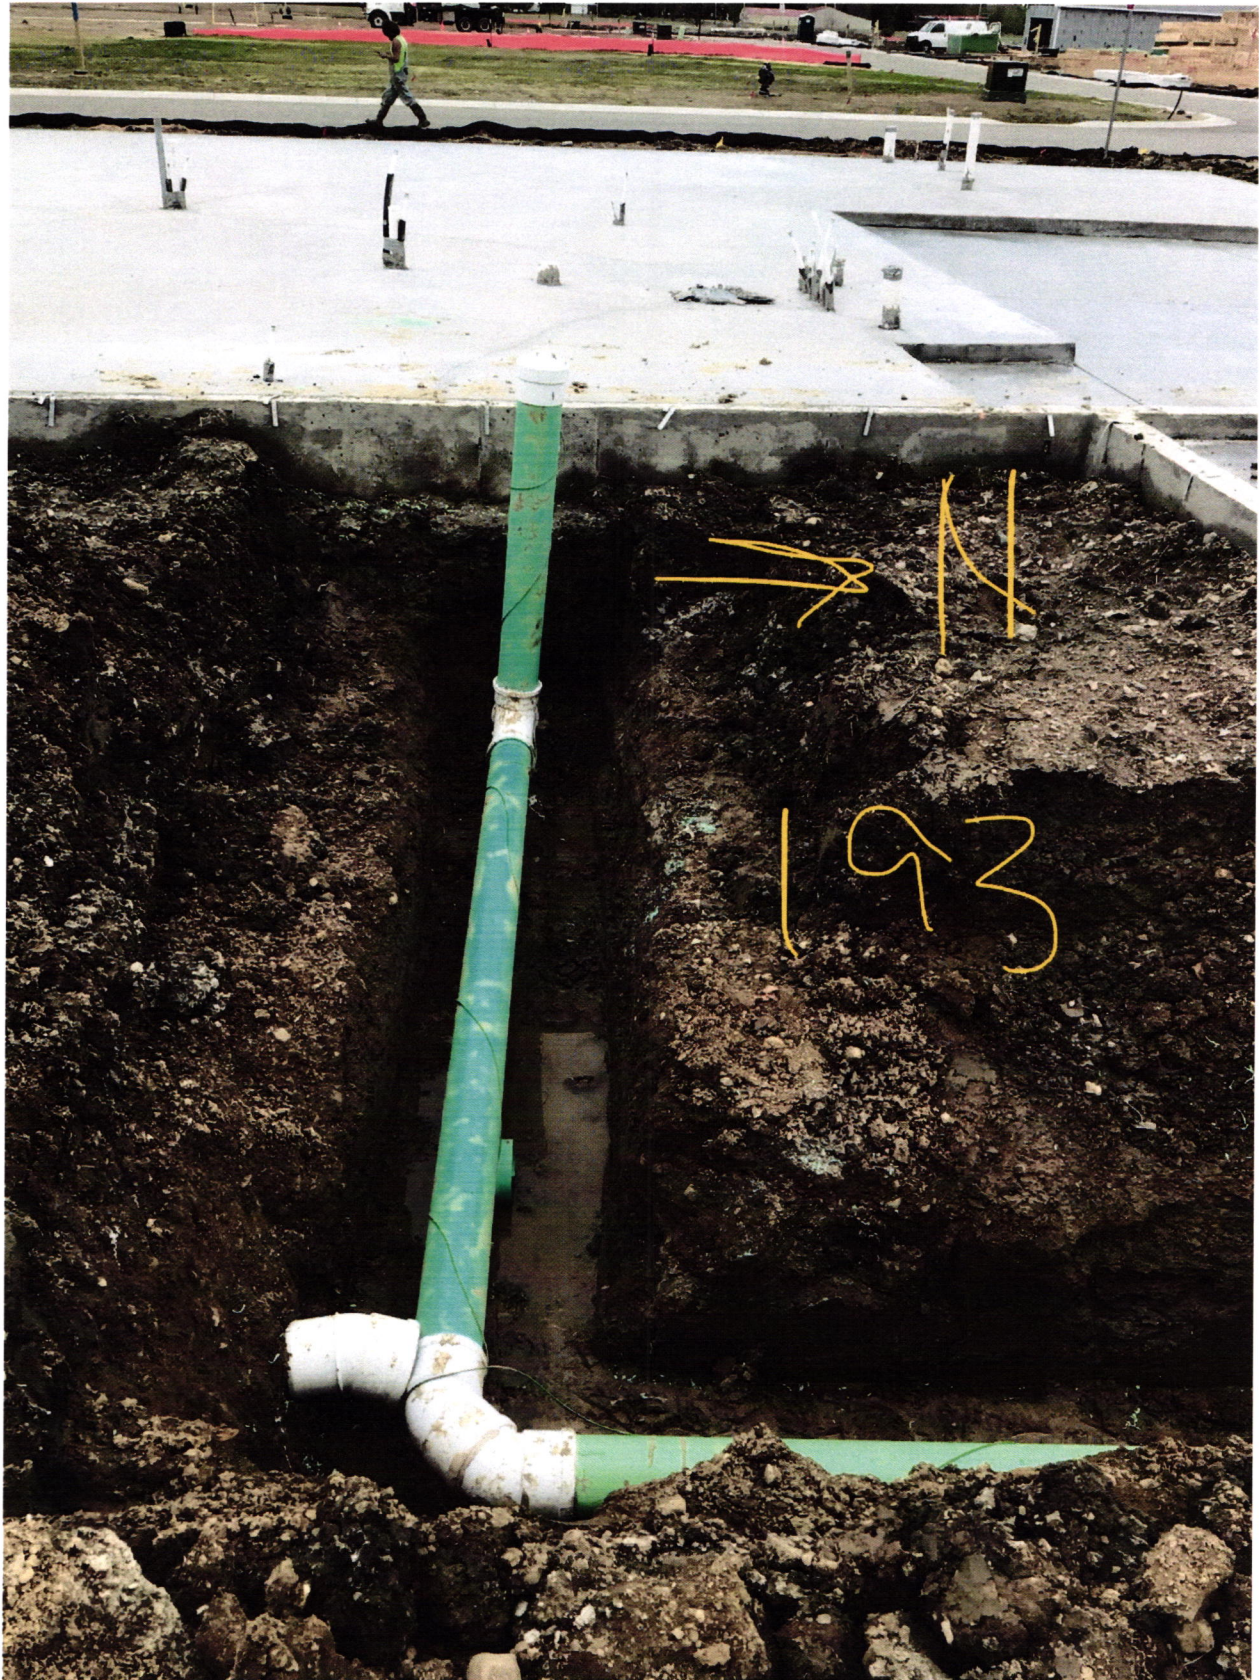

D.R. HORTON
America's Builder**DRH Inc. Controlled Disb**
1341 Horton Circle
Arlington, TX 76011JP Morgan Chase Bank, N.A.
Syracuse, NY**Check Number 1407854**

50-937

213

2720128

Date	Amount
12/01/21	\$*****760.00

Void after 6 months from date of issue

SEVEN HUNDRED SIXTY AND 00/100 *****Pay To The Order Of:
FALL CREEK REGIONAL WASTE DISTRICT
9378 SOUTH 650 WEST
PENDLETON IN 46064D.R. Horton

Rec# 011973