

Gidw.

PROJECT Phase II SHEET _____ OF _____


SUBJECT _____ DATE 5-31-18

JOB NO. 4467

BY Atlas


307 S. Pendleton

N →

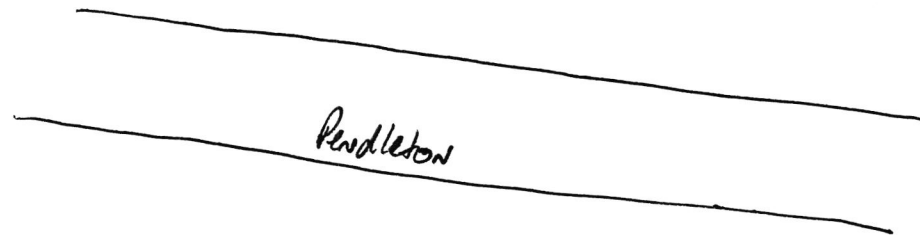

313

lateral for 307 crosses
thru 313's property

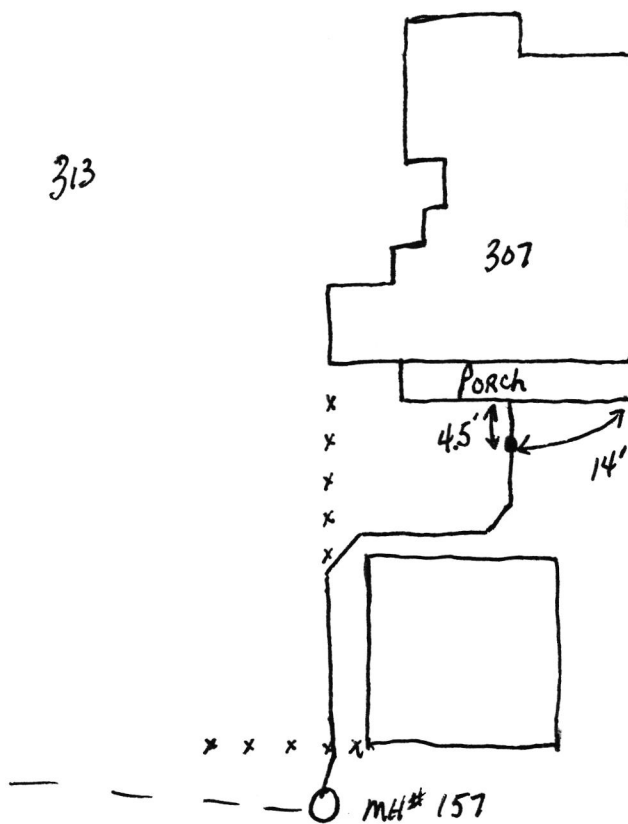

301 S Pendleton

SRF Phase II

6-2-18

