


Side

PROJECT Phase II SHEET _____ OF _____
SUBJECT _____ DATE 2-8-18
JOB NO. 4447
BY Atlas

307 S. West

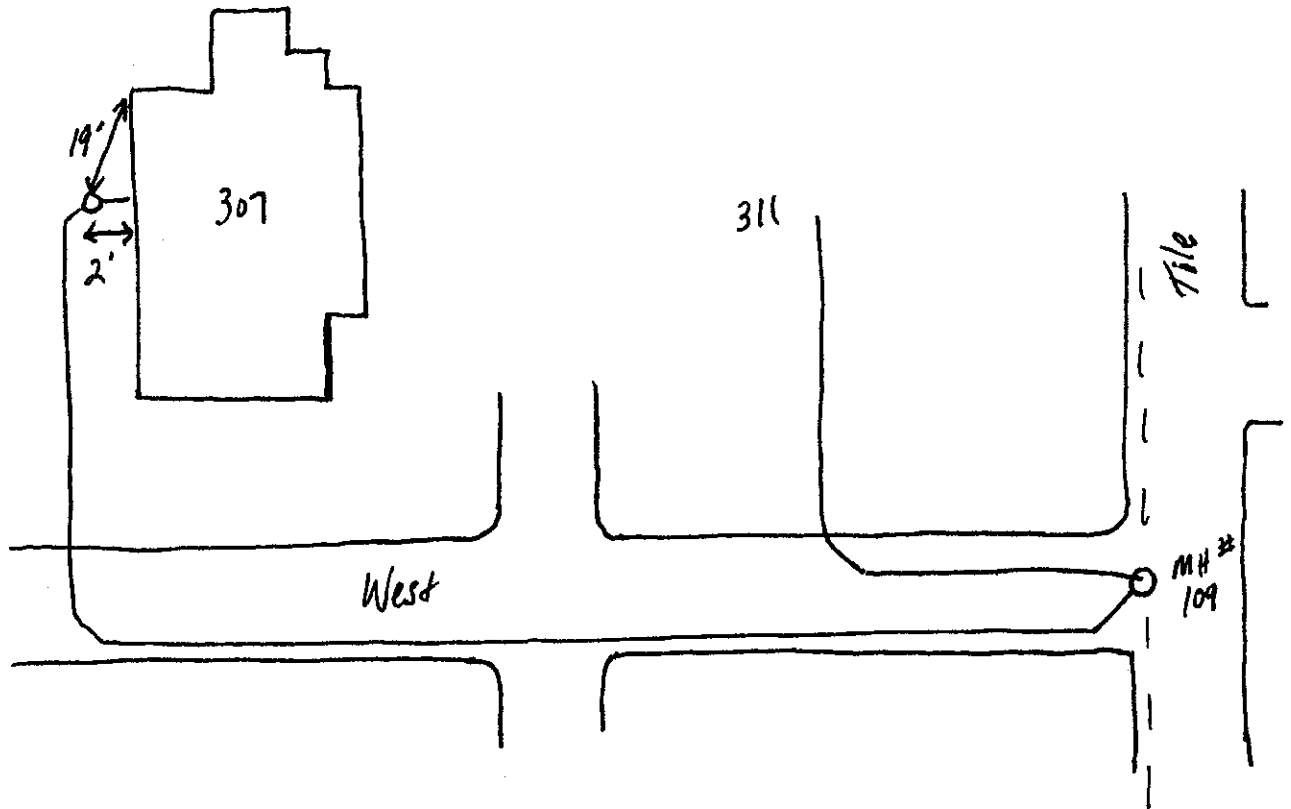

307 S West

SRF Phase II

28.18

