

Gidw.


PROJECT Phase II SHEET _____ OF _____

SUBJECT _____ DATE 1-31-18

JOB NO. 4447

BY Atlas

307 W. Tile

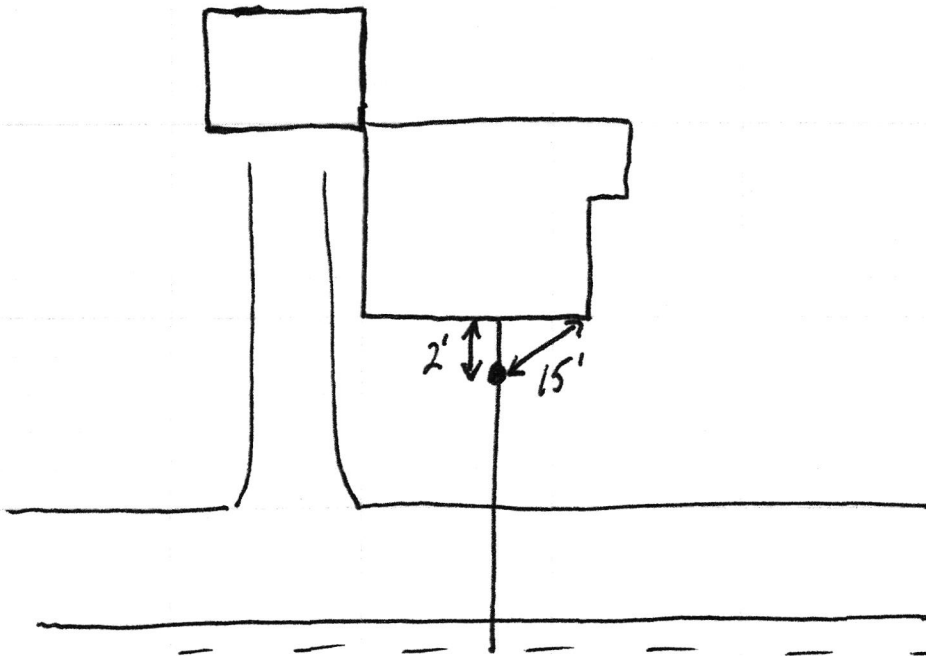

MH# 110
- O

307 w Tile

SRP Phase II

