

Gidw.

PROJECT

Phase II

SHEET

OF

SUBJECT

DATE

7-10-18

JOB NO.


4447

BY

Atlas

308 E. State

← N

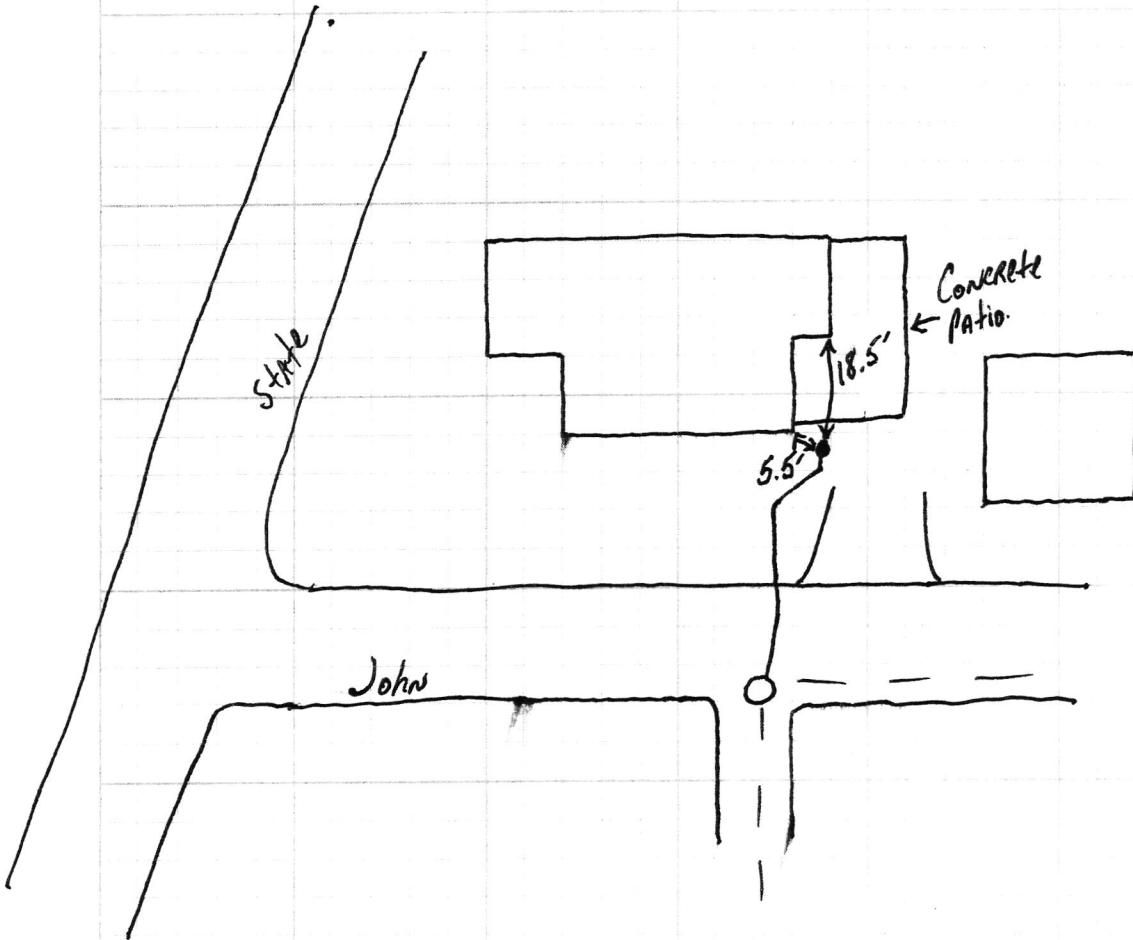

308 & State

SMP Phase II

7.11.18

