

*GLW*

PROJECT

Phase II

SHEET

OF

SUBJECT

DATE

1-25-18


JOB NO.

4447

BY

Atlas

308 E. Walnut

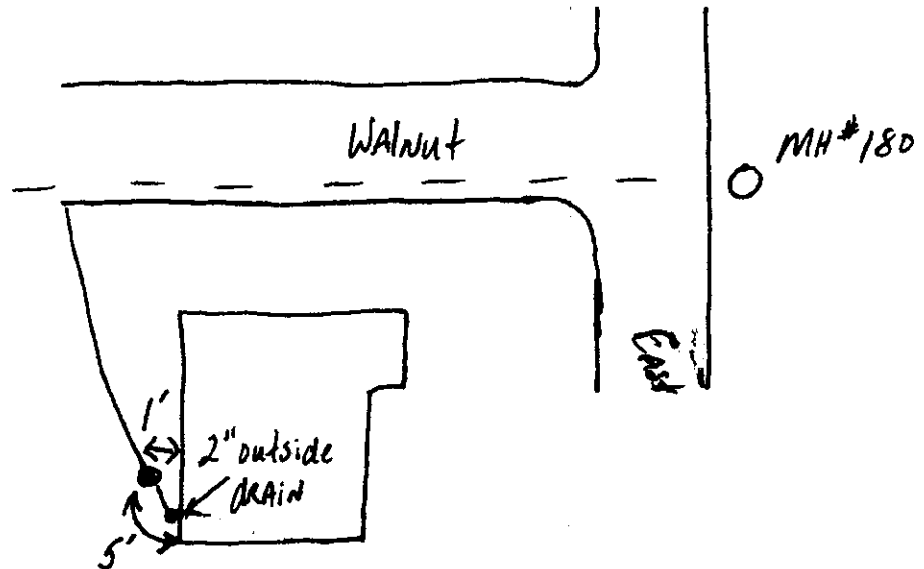

308 E Walnut

SRF Phase II

1.25.18

