

Gidw.

PROJECT

Phase II

SHEET _____ OF _____

SUBJECT


DATE 5-29-18

JOB NO. 4447

BY Atlas

308 S. Broadway

← N

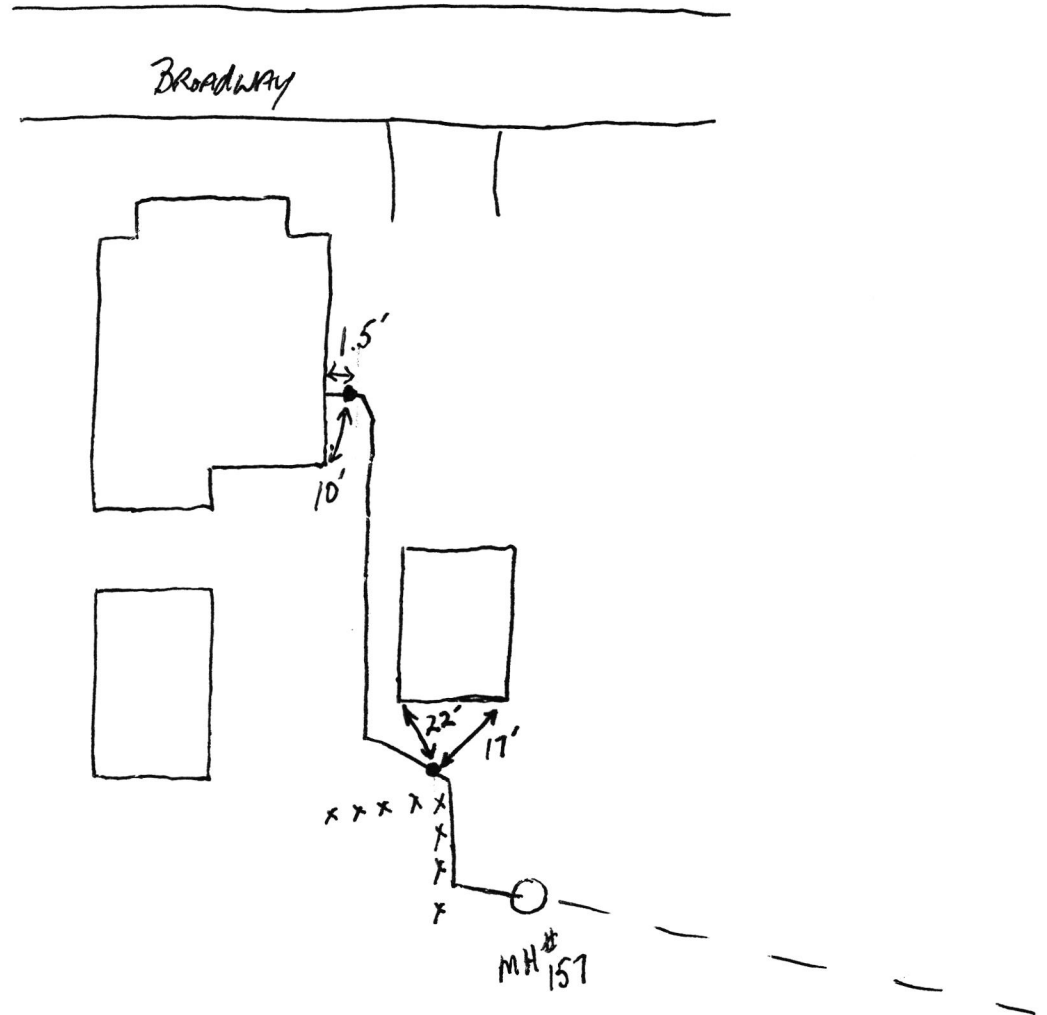

308 S Broadway

SRP Phase II

6.2.18



308 S Broadway

SFF Phase II

6.2.18

