

Gidw.

PROJECT Phase II SHEET _____ OF _____


SUBJECT _____ DATE 5-14-18

JOB NO. 4447

BY Atlas

309 S. MAIN

← N

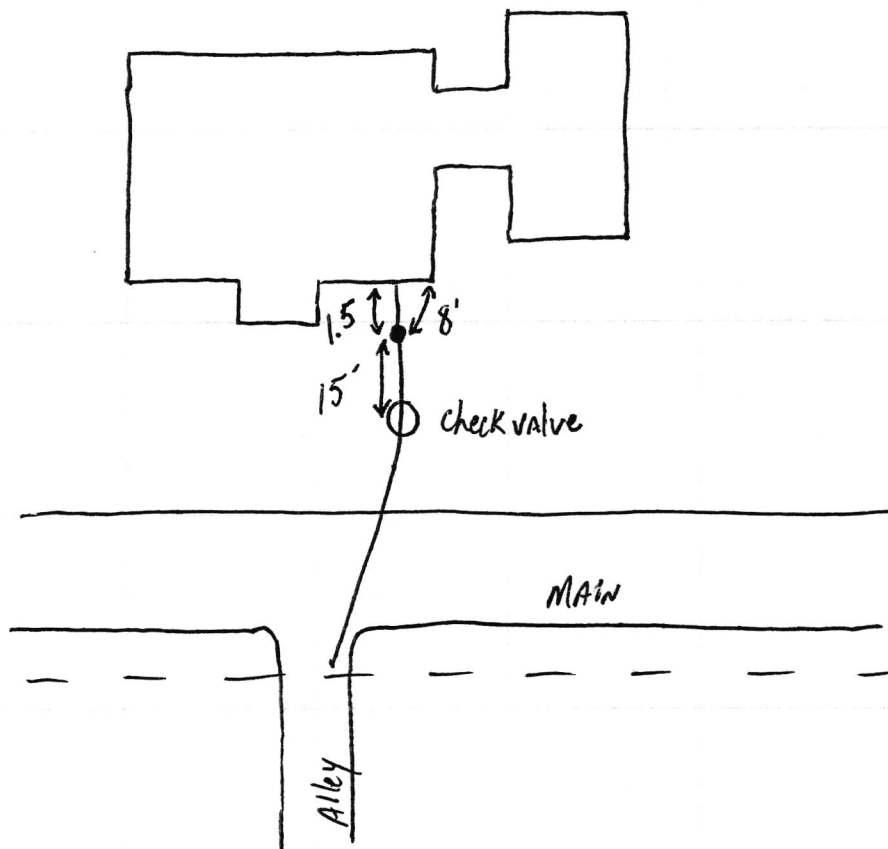



309 S Main

Srf Phase II

5.22.18