

Gidw.


PROJECT Phase II SHEET _____ OF _____

SUBJECT _____ DATE 4-17-18

JOB NO. 4447

BY Atlas

309 W. Taylor

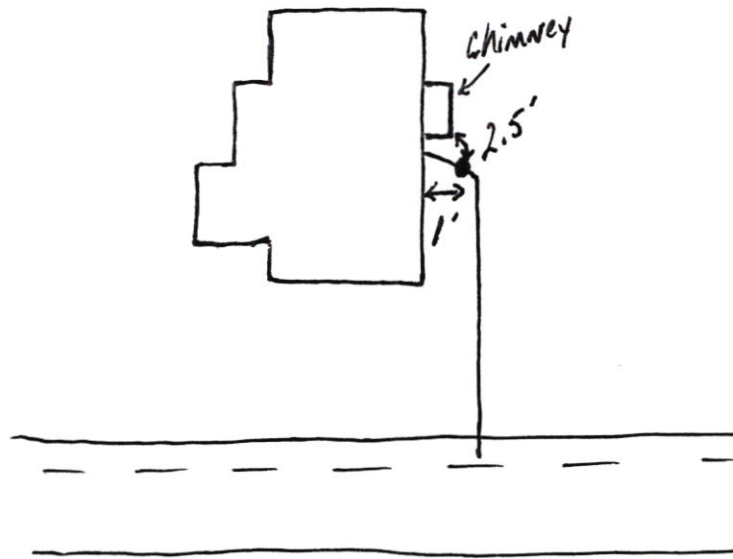

309 W Taylor

SRP
Phase II

4.20.18

