



FALL CREEK REGIONAL WASTE DISTRICT

9378 S. 650 West PO Box 59
Pendleton, IN 46064-0059 778-7544

23-00820.00

Nº 2548

APPLICATION FOR SEWER PERMIT

Date

8-4-98

Permit Void 90 days from Date of Issuance

Owner Name

Roger W. Wood

Property Address

3100 W. Huntsville Rd. Pendleton

Lot #

P.O. Box

Town

Pendleton

, IN Zip Code

46064

Phone

7783331

City Water

Well

☒

\$ Tap on Fee Paid

\$ Inspection fee paid

Application is hereby made for connection to the Fall Creek Regional Waste District Sewer System for the above listed property - Permit Type: Residential ☒, Commercial ☐, Industrial ☐, or Governmental/Institutional ☐. User Information

All workmanship and materials shall conform to the standards of the District Ordinance as described in Ordinance 84-2 and 84-3 as amended. Acceptance and approval must be made by the District inspector or his duly authorized representative before backfilling and final connection is made to the main sewer lines. Any violation of applicable regulations will cause all lines and appurtenances in violation to be removed and replaced at the owners expense.

The Fall Creek Regional Waste District is responsible for the inspection, approval of materials, and installation techniques only. All costs for materials and installation and any liabilities resulting from same is the sole responsibility of the property owner.

I have read and fully understand the above provisions and agree to comply by said provisions.

Roger Wood

APPLICANT(S) SIGNATURE

INSPECTOR

Tim

Date inspected

8/10/98

Approved

☒

Rejected

Reason for rejection

Date reinspected

Approved

Rejected

Notes:

Size Pipe

6"

Type Pipe

SDR 26

Basement Yes

☒ No

Sump Pump Yes

☒ No

Downspout to Ground Yes

☒ No

Septic Tank Pumped & filled Yes

☒ No

Contractor


SELF

Special Conditions

Existing Home

☒

New Construction

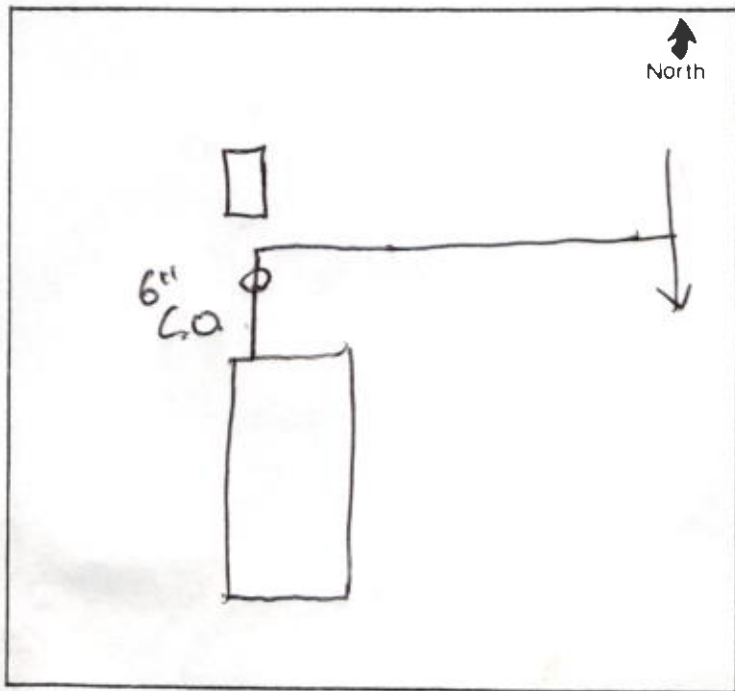



FALL CREEK REGIONAL WASTE DISTRICT
9375 E. 10th Street
Bend, Oregon 97701-1500

22-008000

No 2248

8-4-78

Project Name: Rocky Mountain
Property Address: 3100 Whittier St. Reno, NV

Job No: 7773331
City/State: Rocky Mountain

Project Description: Removal of asbestos containing materials from the roof of the building.

The following information was obtained from the project description and the asbestos survey report. The project involves the removal of asbestos containing materials from the roof of the building. The materials to be removed are asbestos containing materials (ACM) in the form of roof tiles and insulation. The removal process will involve the use of wet methods to minimize dust and the use of proper containment and disposal procedures. The project is scheduled to begin on 8/16/78 and is expected to be completed by 8/22/78.

Rocky Mountain

Jim

8/16/78

