



# FALL CREEK REGIONAL WASTE DISTRICT

9378 S. 650 West PO Box 59  
Pendleton, IN 46064-0059 778-7544

10-24210.00

## APPLICATION FOR SEWER PERMIT

Nº 2800

Date 6/8/2000

Permit Void 90 days from Date of Issuance

Owner Name Papa John's

Property Address 3104 W U.S. 36 - Unit 2C

Lot # \_\_\_\_\_ P.O. Box \_\_\_\_\_

Town Pendleton, IN Zip Code 46064

Phone \_\_\_\_\_ City Water ☒ Well \_\_\_\_\_

\$ \_\_\_\_\_ Tap on Fee Paid

\$ \_\_\_\_\_ Inspection fee paid

Application is hereby made for connection to the Fall Creek Regional Waste District Sewer System for the above listed property - Permit Type: Residential ☒, Commercial \_\_\_\_\_, Industrial \_\_\_\_\_, or Governmental/Institutional \_\_\_\_\_. User Information \_\_\_\_\_.

All workmanship and materials shall conform to the standards of the District Ordinance as described in Ordinance 84-2 and 84-3 as amended. Acceptance and approval must be made by the District inspector or his duly authorized representative before backfilling and final connection is made to the main sewer lines. Any violation of applicable regulations will cause all lines and appurtenances in violation to be removed and replaced at the owners expense.

The Fall Creek Regional Waste District is responsible for the inspection, approval of materials, and installation techniques only. All costs for materials and installation and any liabilities resulting from same is the sole responsibility of the property owner.

I have read and fully understand the above provisions and agree to comply by said provisions.

APPLICANT(S) SIGNATURE \_\_\_\_\_

\*\*\*\*\*

INSPECTOR T

Date inspected 6-8-00 Approved ☒ Rejected \_\_\_\_\_

Reason for rejection \_\_\_\_\_

Date reinspected \_\_\_\_\_ Approved \_\_\_\_\_ Rejected \_\_\_\_\_

Notes:

Size Pipe 6"

Type Pipe SDR35

Basement Yes \_\_\_\_\_ No ☒

Sump Pump Yes \_\_\_\_\_ No ☒

Downspout to Ground Yes ☒ No \_\_\_\_\_


Septic Tank Pumped & filled Yes \_\_\_\_\_ No \_\_\_\_\_

Contractor GARY RINCY

Special Conditions \_\_\_\_\_

Existing Home ☒

New Construction ☒

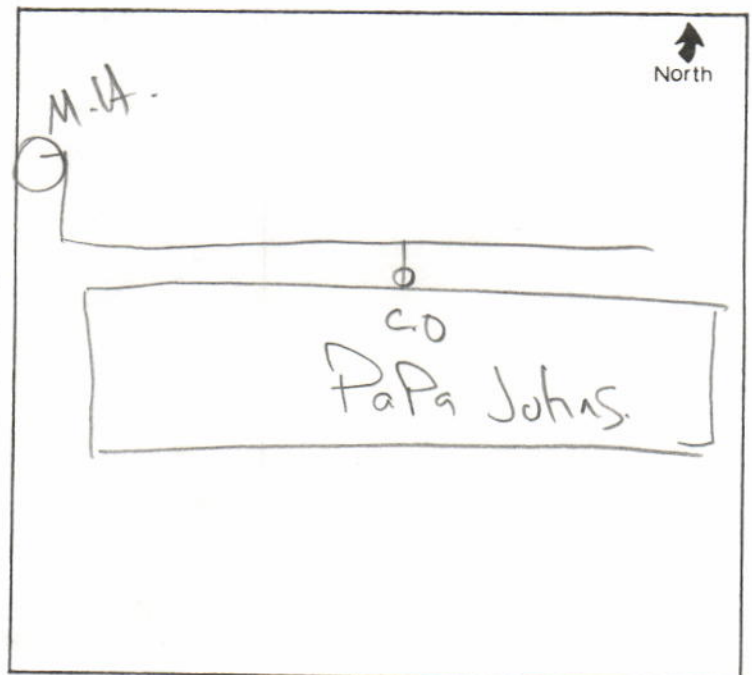



## FALL CREEK REGIONAL WASTE DISTRICT

P.O. Box 59 • 9378 S. 650 West • Pendleton, Indiana 46064-0059 • (317) 778-7544

---

January 24, 1996

Mr. Wm. Redding  
631 N. Pendleton Avenue  
Pendleton, IN 46064

RE: Sanitary sewer connection fees

Dear Mr. Redding:

The purpose of this letter is to notify you of our sanitary sewer connection fees. Normally, when we extend our sanitary sewer lines into a new area, we send connect notices to the affected residents explaining connect procedures and fees. However, your residence was connected before we sent notices to your area.

There is a \$2700 residential tap-on fee and a \$25 inspection fee payable upon receipt of this notice. Payment may be made at our Administrative Office, 9378 S County Road 650 West, Pendleton, Indiana 46064. A Time Payment Plan is available for this fee. If you are interested in the details of the Time Payment Plan, please call our Office Manager at 778-7544.

We look forward to hearing from you.

Sincerely,

  
Joe F. Rowlett  
General Manager