

Gidw.


PROJECT Phase II SHEET \_\_\_\_\_ OF \_\_\_\_\_

SUBJECT \_\_\_\_\_ DATE 2-27-18

JOB NO. 4447

BY Atlas

310 Laurel

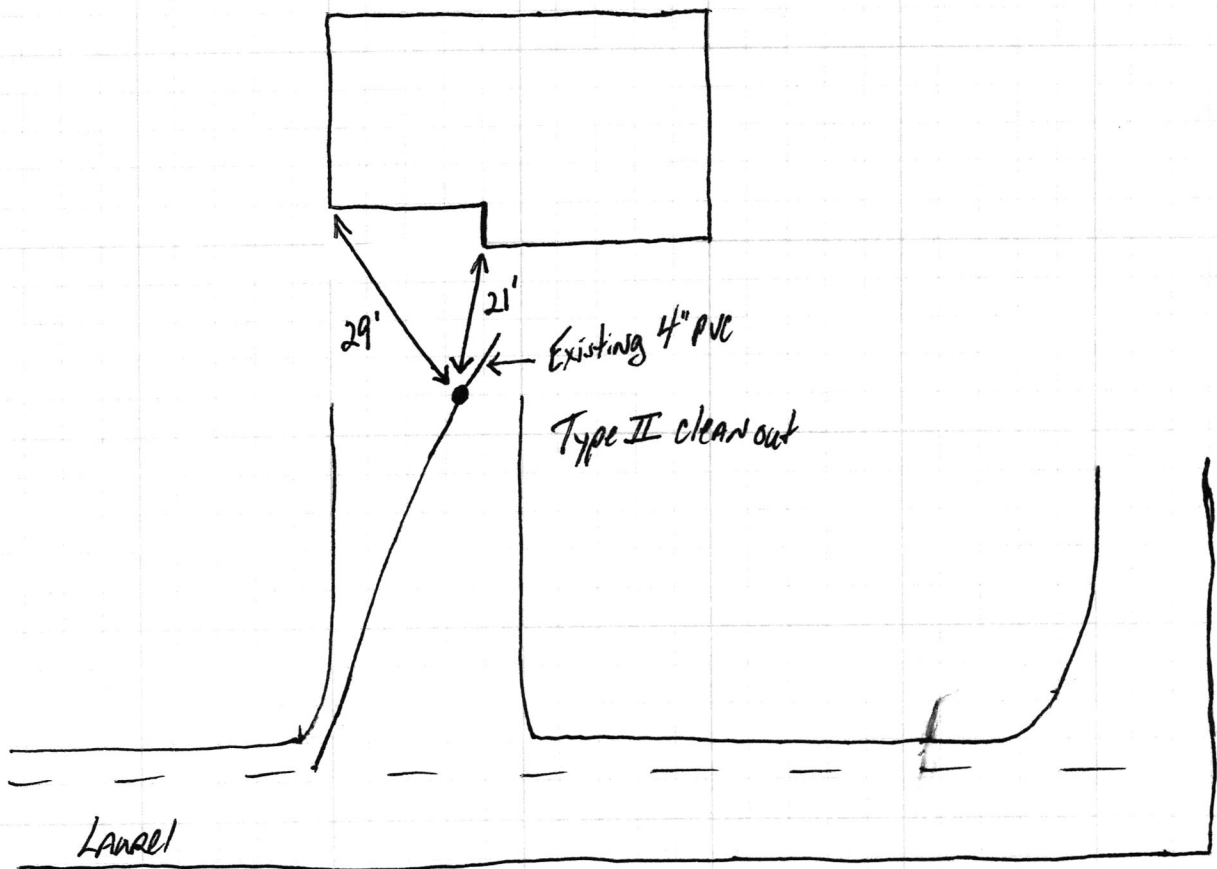

310 Laurel ST

SRF Phase II







# FALL CREEK REGIONAL WASTE DISTRICT

Box 44, Pendleton, Indiana 46064

2-04192.00

## APPLICATION FOR SEWER PERMIT

Nº 001757

Permit No. \_\_\_\_\_ Date \_\_\_\_\_  
Permit Void 90 days from Date of Issuance  
Owner Name Ted Brown  
Property Address 310 Laurel  
Lot # \_\_\_\_\_ P.O. Box \_\_\_\_\_  
Town Pendleton, IN Zip Code 46064  
Phone 778 3114 Water Meter \_\_\_\_\_  
\$ 500<sup>00</sup> Tap on Fee Paid Paid To Ben on Job site  
\$ 25<sup>00</sup> Inspection fee paid

Application is hereby made for connection to the Fall Creek Regional Waste District Sewer System for the above listed property - Permit Type: Residential X, Commercial \_\_\_\_\_, Industrial \_\_\_\_\_, or Governmental/Institutional \_\_\_\_\_. User Information \_\_\_\_\_.

All workmanship and materials shall conform to the standards of the District Ordinance as described in Ordinance 84-2 and 84-3 as amended. Acceptance and approval must be made by the District inspector or his duly authorized representative before backfilling and final connection is made to the main sewer lines. Any violation of applicable regulations will cause all lines and appurtenances in violation to be removed and replaced at the owners expense.

The Fall Creek Regional Waste District is responsible for the inspection, approval of materials, and installation techniques only. All costs for materials and installation and any liabilities resulting from same is the sole responsibility of the property owner.

I have read and fully understand the above provisions and agree to comply by said provisions.

Ted Brown  
APPLICANT(S) SIGNATURE

\*\*\*\*\*

INSPECTOR ✓ Ben  
Date inspected 8-31-90 Approved ✓ Rejected \_\_\_\_\_  
Reason for rejection \_\_\_\_\_

Date reinspected \_\_\_\_\_ Approved \_\_\_\_\_ Rejected \_\_\_\_\_

Notes:  
Size Pipe 4"  
Type Pipe PVC  
Basement Yes • No X  
Sump Pump Yes • No X to ground  
Downspout to Ground Yes X No \_\_\_\_\_  
Septic Tank Pumped & filled Yes \_\_\_\_\_ No X  
Contractor RON RHEA  
Special Conditions NEW CONST  
HOME NOT IN YET  
Ted will Notify when  
Moved in

