


Gidw.

PROJECT Phase II SHEET _____ OF _____
SUBJECT _____ DATE 12-18-17
JOB NO. 4447
BY Atlas

310 S. Pendleton

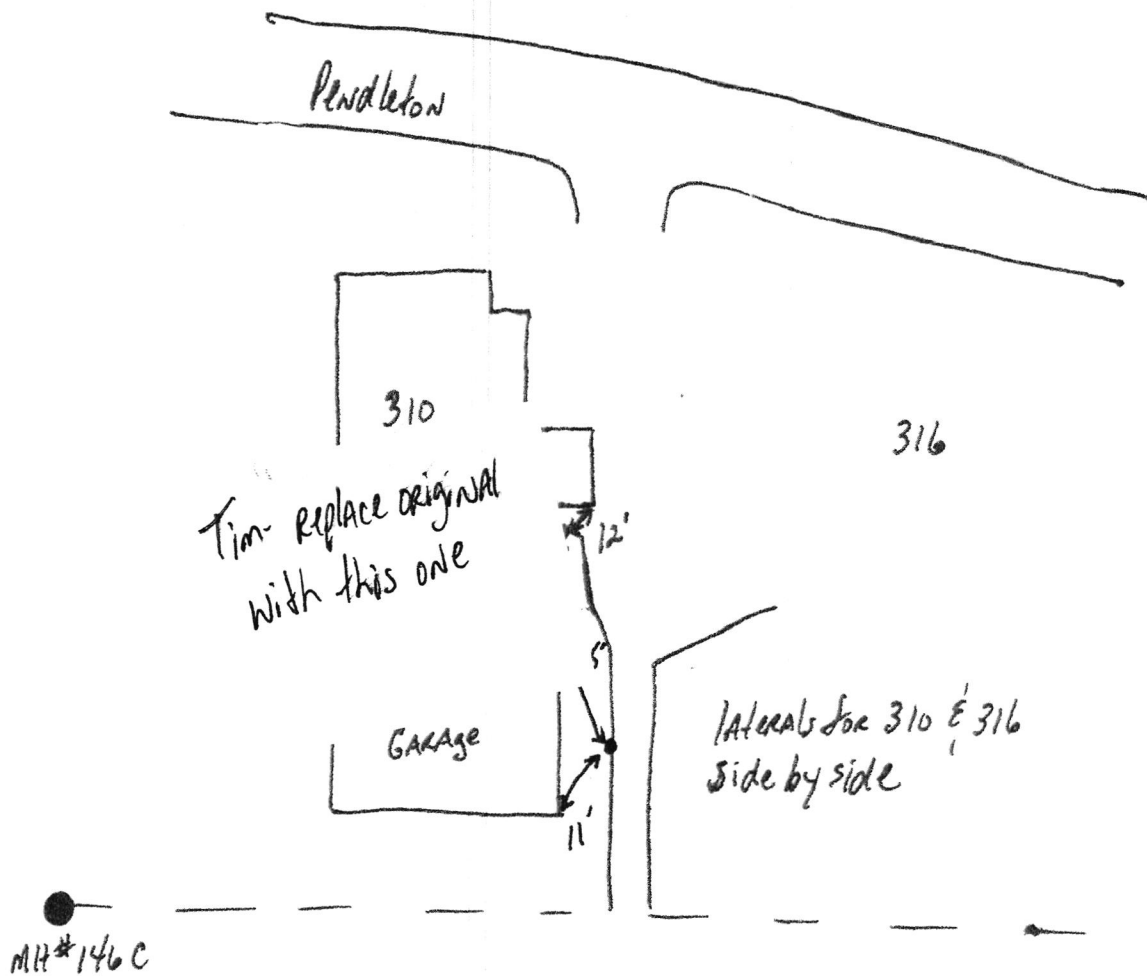

310 S Pendleton Ave

SRF Phase II

12.27.17

