

Fall Creek Regional Waste District
9378 S 650 W, P.O. Box 59, Pendleton, IN 46064
765-778-7544

#8126

Agreement for Sanitary Sewer Service

This Agreement made and entered into this 4 day of March, 2022, between Fall Creek Regional Waste District ("District") and Justin Builders ("Applicant") regarding the provision of sanitary sewer service, and the assignment of capacity in and connection to, the District's facilities for the premises located at lot # 192.

Street Address: 311 Bay Ridge Dr.

Now therefore, the parties, in consideration of the mutual promises set out in this Agreement, the receipt and sufficiency of which is hereby acknowledged, agree as follows:

1. The Applicant agrees that all workmanship and materials shall conform to all District ordinances and the District's construction standards. District must accept and approve all work and materials before backfilling and final connection is made to the sewer mains. Any violation of this provision will cause all lines and appurtenances in violation to be removed and replaced at the Applicant's expense.
2. The District shall have the right to enter upon the Applicant's premises at all reasonable times to inspect, repair, or replace any equipment used in connection with the District's service or which has an impact on said service.
3. The Applicant shall be responsible for all monthly user rates, capacity charges, and tap fees. The failure to pay any rate charge or fee may result in a lien against the property and/or the termination of service to the property, the cost of which will be borne by Applicant, including, but not limited to, all attorney's fees and collection costs.
4. The District shall not be responsible for any damages as a result of any failure to supply service unless said damages are due to default, neglect or culpability on the part of the District.
5. If there is an available sanitary sewer within three hundred (300) feet of the property line, the property owner shall be required to connect to the District's sanitary sewer system.
6. The Applicant and District agree that the provision of sanitary sewer service touches and concerns the property and the terms of this Agreement bind the District and Applicant and their heirs, executors, administrators, personal representatives, successors, agents, attorneys, assigns, designees, and transferees.

The parties hereto have read and fully understand the above provisions and agree to comply with said provisions.


FALL CREEK REGIONAL WASTE DISTRICT
Rachel E. Lawyer
Signature

APPLICANT

Laurenza E. Johnson
Signature

STATE OF INDIANA)
) SS:
COUNTY OF MADISON)

SUBSCRIBED and sworn to before me this 4 day of March, 2022

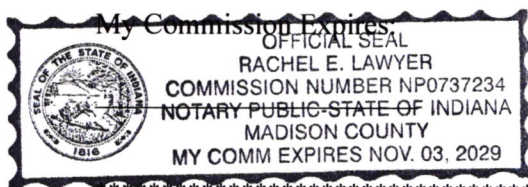

Signature

Printed

Notary Public


Resident of Madison County


Inspector Dor Date Inspected 4-12-22 Approved ✓ Rejected _____
Reason for Rejection _____

Date Reinspected _____ Approved _____ Rejected _____

Notes:

Size Pipe 6" Type Pipe PVC 35
Basement Yes _____ No _____
Sump Pump Yes _____ No _____
Downspout to Ground Yes _____ No _____
Septic Tank Pumped & Filled Yes _____ No _____
Contractor Bolton
Special Conditions _____
Existing Home _____
New Construction ✓

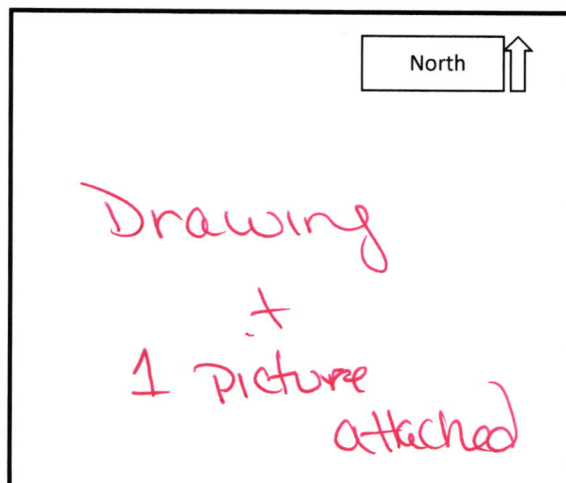

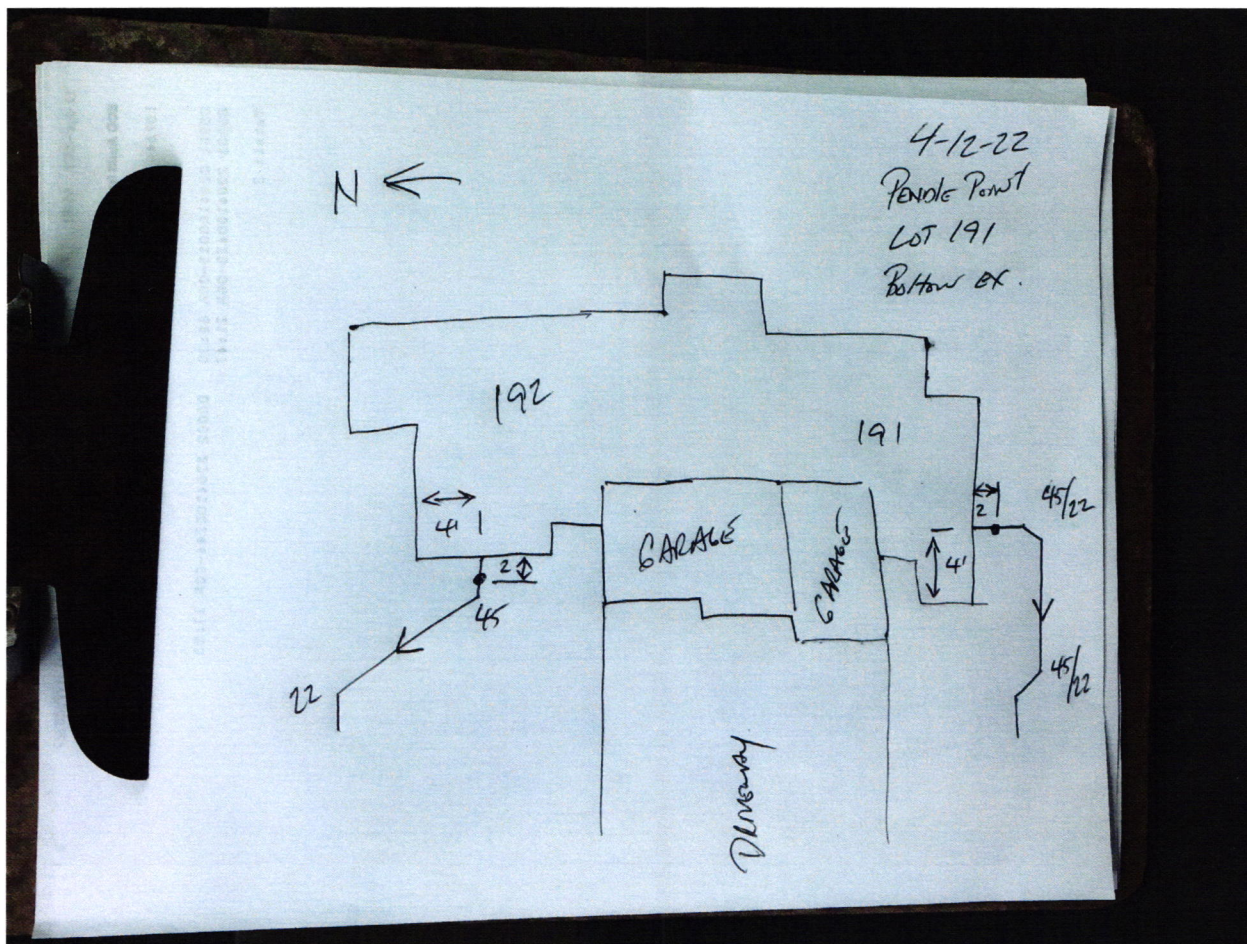





MUSTIN BUILDERS, INC.

810 CENTRAL AVENUE

ANDERSON, IN 46012

PH. 765-644-8502



PO Box 11409 • Fort Wayne, IN 46858-1409

71-167749

401038

Sixteen Thousand Six Hundred Forty & ⁰⁰/₁₀₀

DATE

3-4-2022

CHECK NO.

401038

AMOUNT

st 16,640.⁰⁰/₁₀₀

PAY
TO THE
ORDER
OF

F.C. R.W.D.

AUTHORIZED SIGNATURE

MP

Rec # 012132