


**Gidw.**

PROJECT Phase II SHEET \_\_\_\_\_ OF \_\_\_\_\_

SUBJECT \_\_\_\_\_ DATE 7-9-18

JOB NO. 4447

BY Atlas

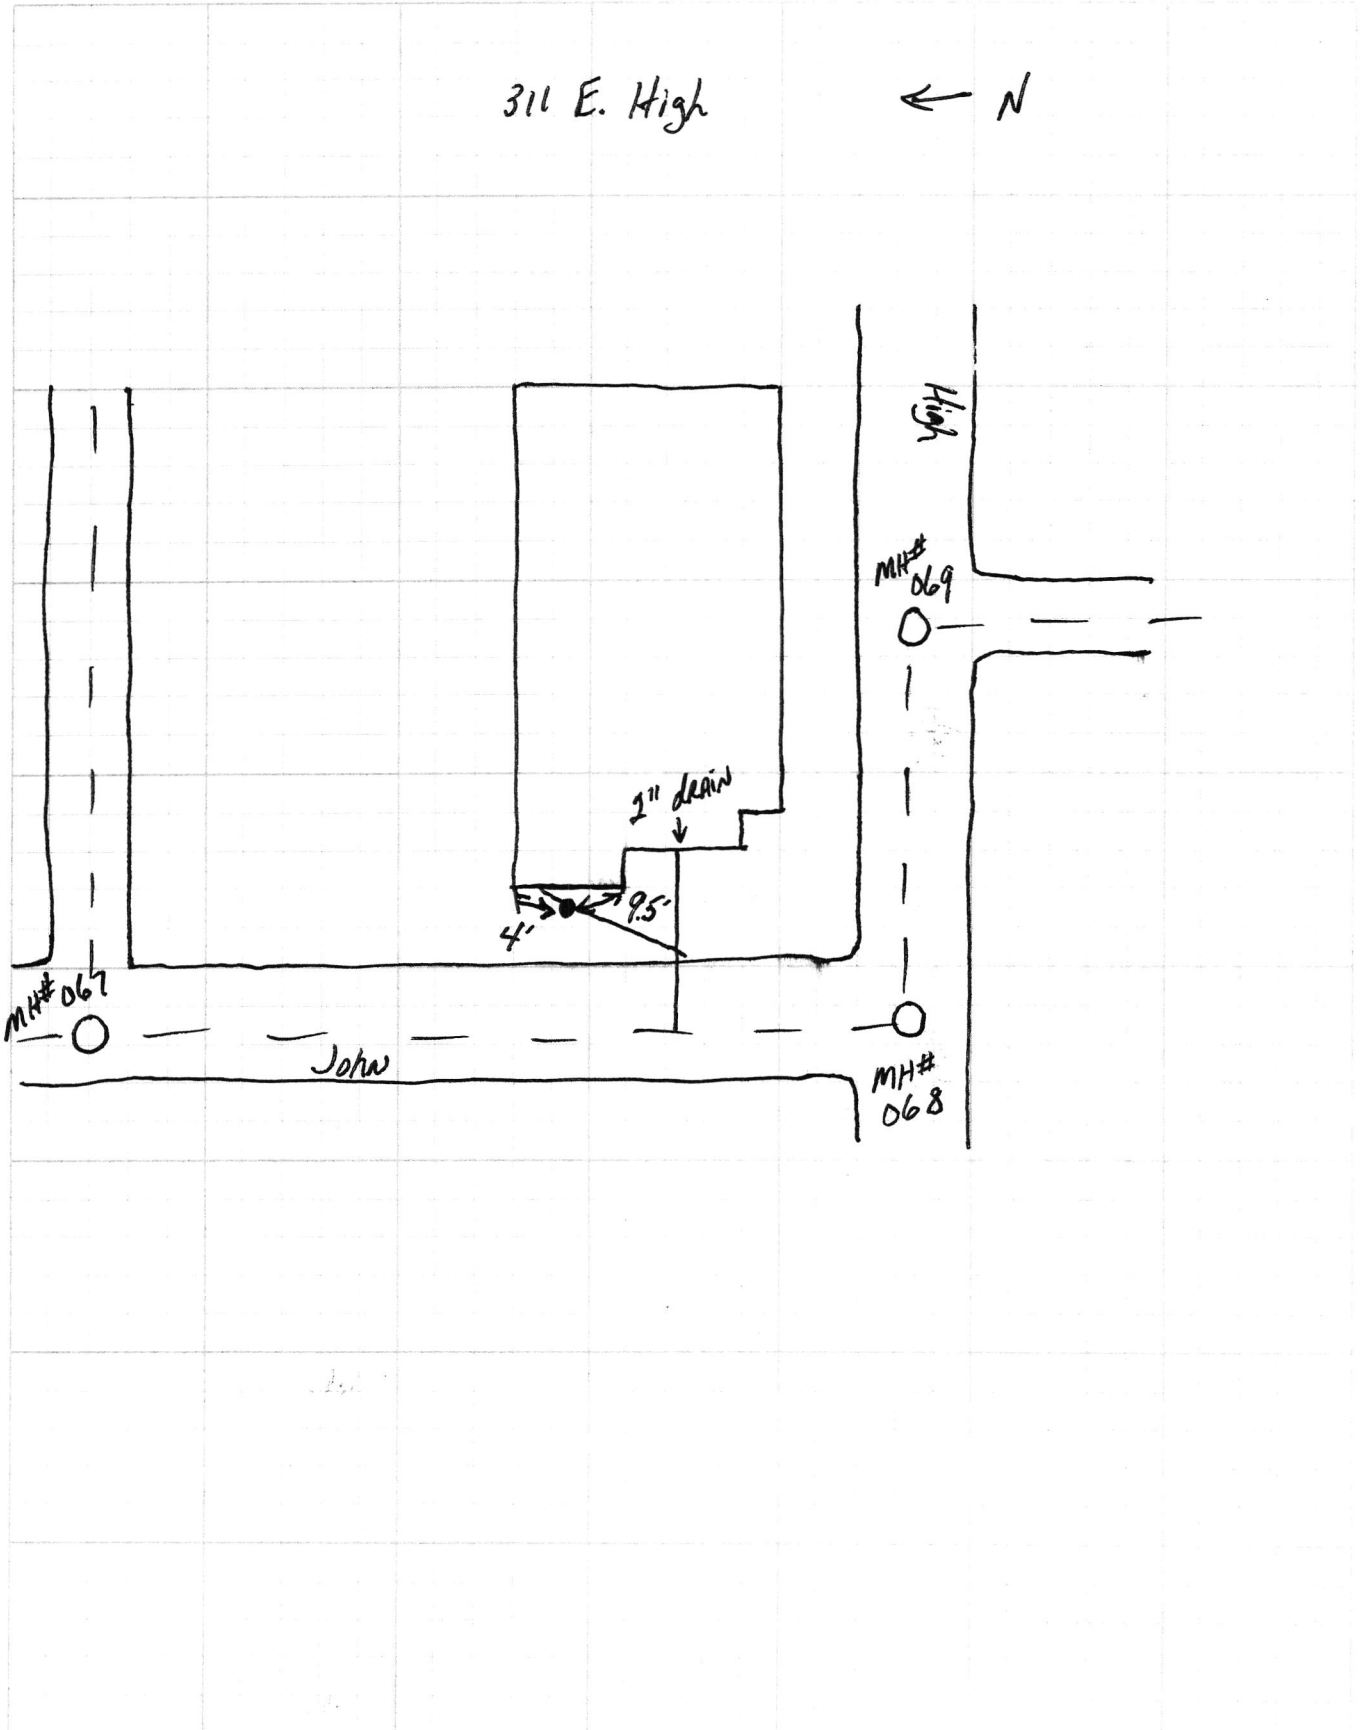

311 & High SRP Phase II

7.11.18

