

Project 311 Laurel

SHEET _____ OF _____


Subject _____

DATE 11-17-17

JOB NO 4447

BY Atlas

311 Laurel

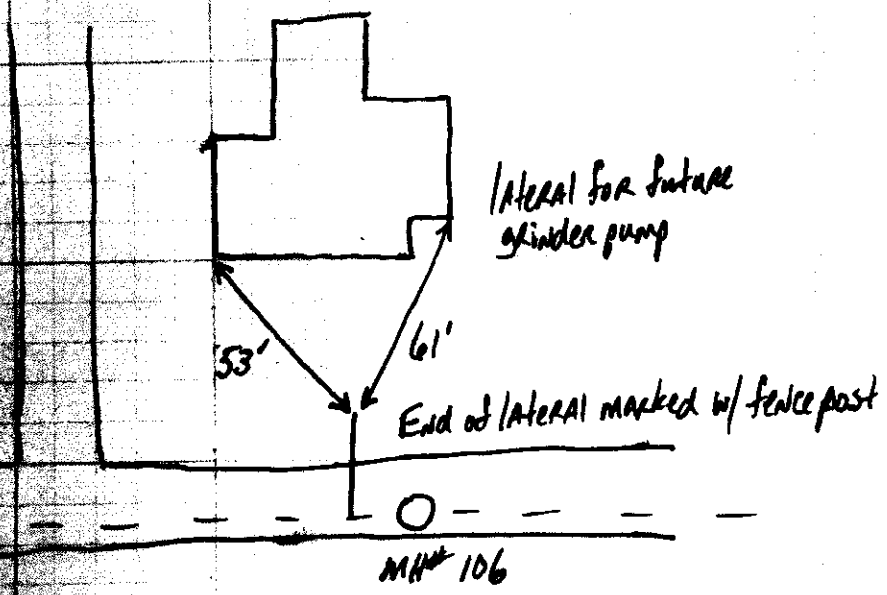

311 Laurel St

SRP Phase II
Dec '17

