

G.R.W.

PROJECT PHASE II

SHEET _____ OF _____


SUBJECT _____

DATE 7-3-18

JOB NO 4447

BY ATLAS

311 PEARL ST.

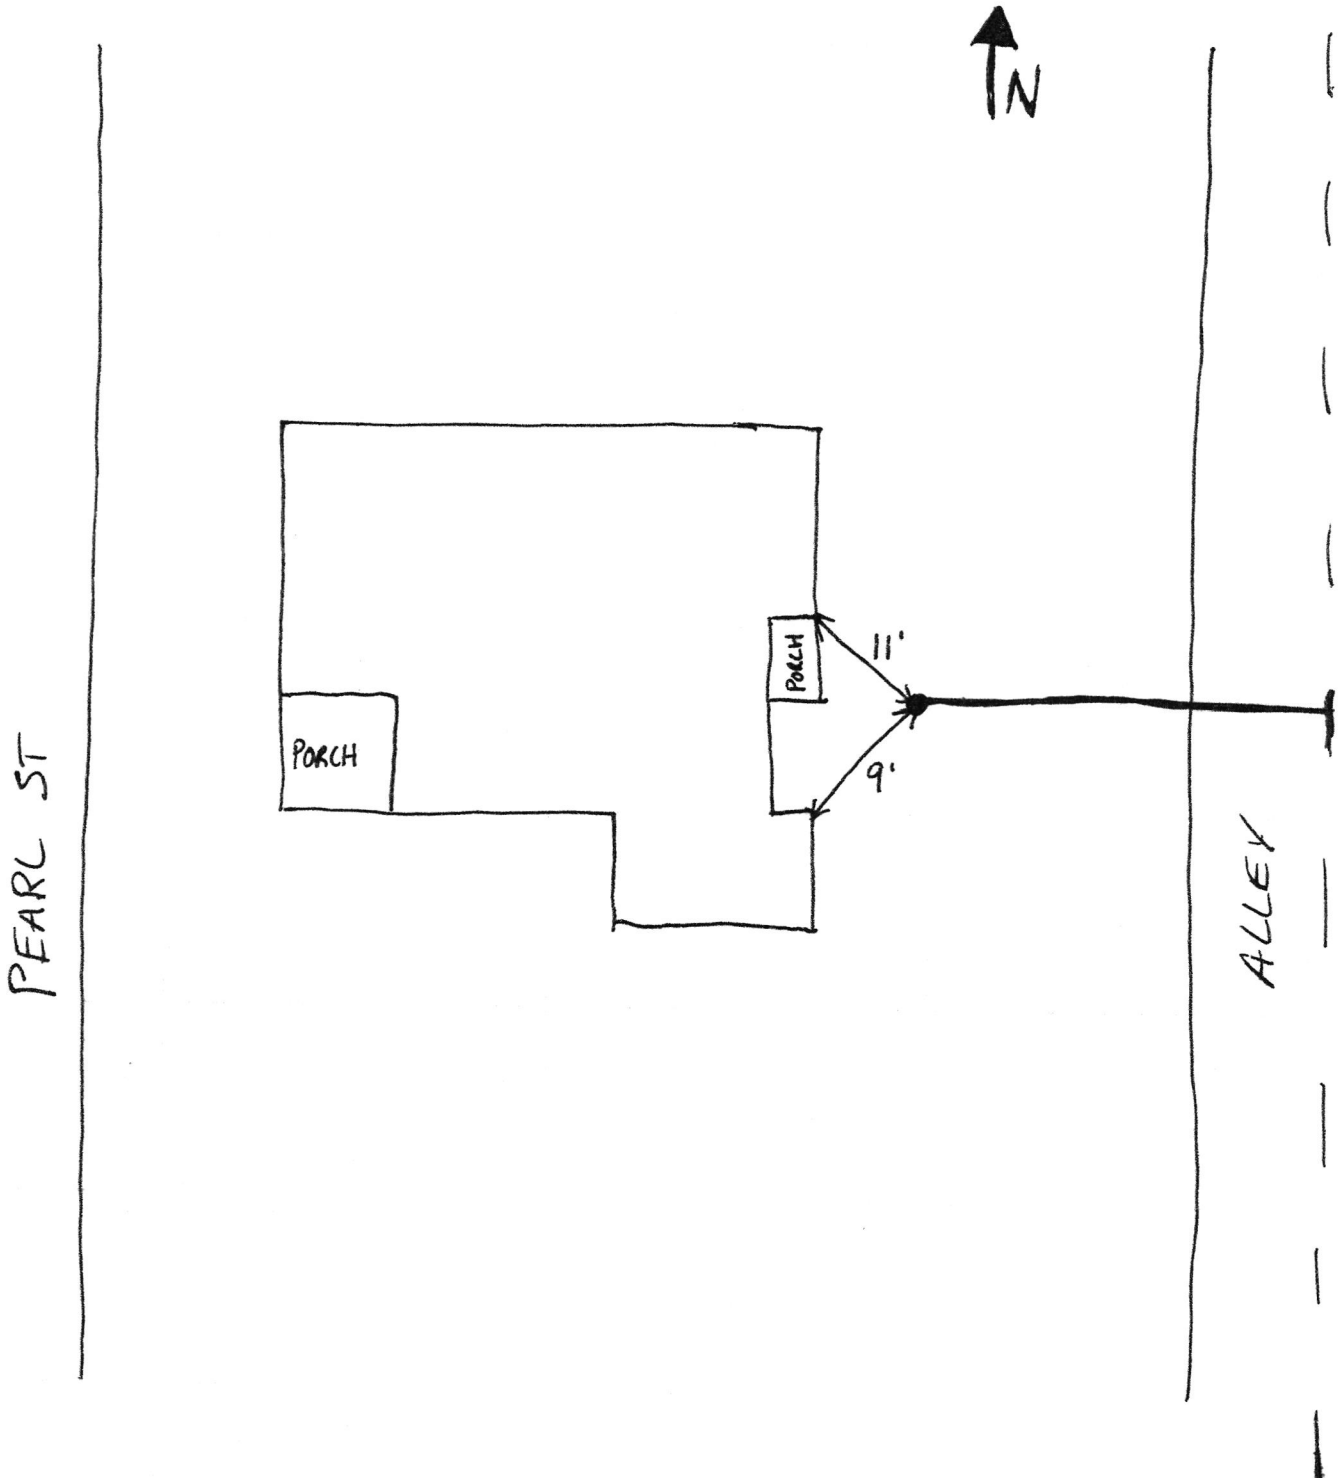

311 Pearl

SRF Phase II

7.6.18

