


Gidw.

PROJECT Phase II SHEET _____ OF _____
SUBJECT _____ DATE 7-23-18
JOB NO. 4447
BY Atlas

311 S. BROADWAY

N →

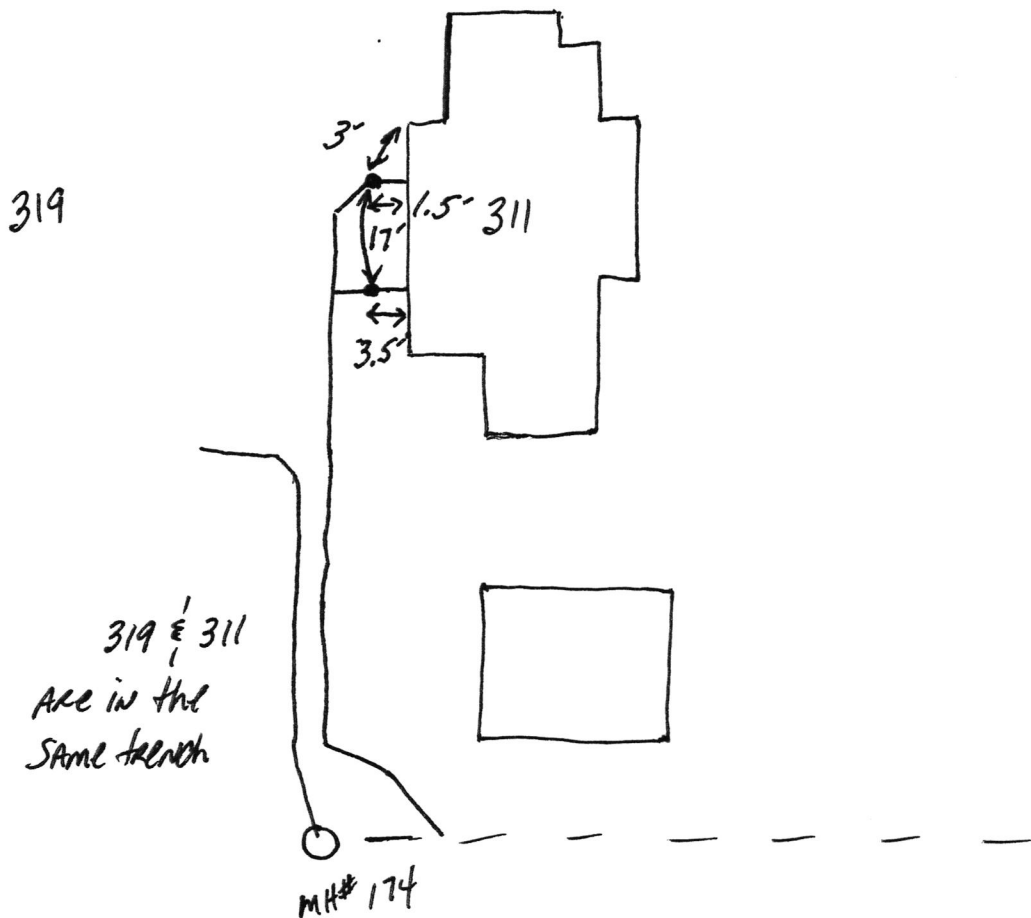

311 S Broadway

SRT Phase II

7.30.18



311 S Broadway

SRF Phase II

7.30.18

