

Gidw.


PROJECT Phase II SHEET _____ OF _____

SUBJECT _____ DATE 2-1-18

JOB NO. 4447

BY Atlas

311 W. Tile

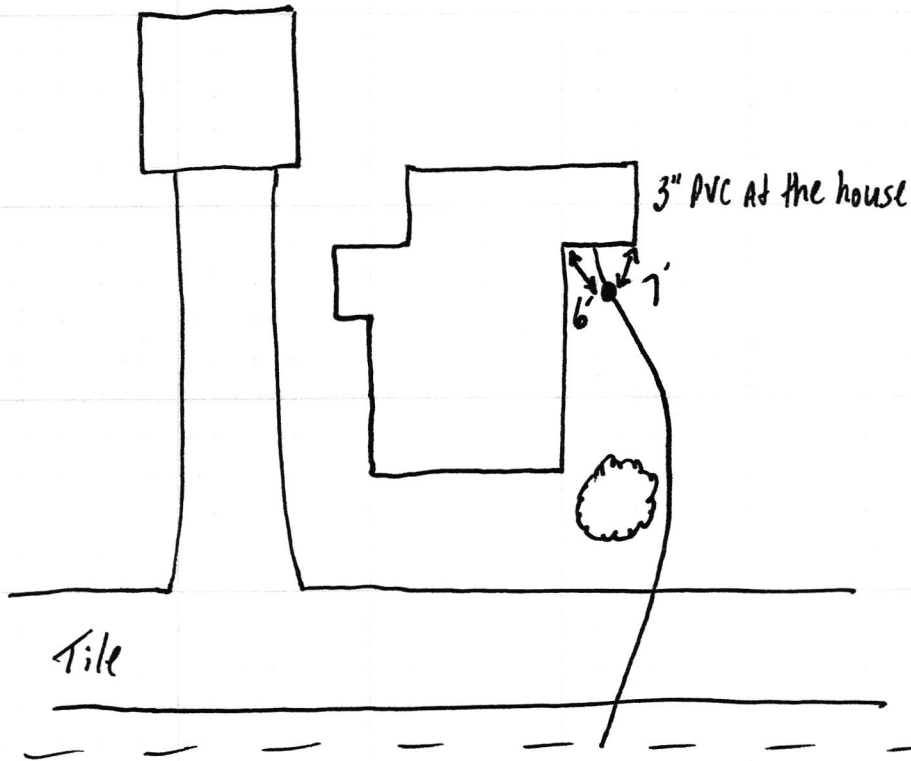

MA#110
○

311 W Tile

SRF Phase II

