



FALL CREEK REGIONAL WASTE DISTRICT

9378 S. 650 West PO Box 59
Pendleton, IN 46064-0059 778-7544

23-01460.00

APPLICATION FOR SEWER PERMIT

Nº 2533

Date 7-27-98

Permit Void 90 days from Date of Issuance

Owner Name ARTHUR OWEN & DOROTHY GERALDINE EMMERLING

Property Address 3127 W. MARKET ST

Lot # _____ P.O. Box _____

Town PENDLETON, IN Zip Code 46064-9027

Phone (765) 778-2454 City Water _____ Well X

\$ NA Tap on Fee Paid

\$ NA Inspection fee paid

Application is hereby made for connection to the Fall Creek Regional Waste District Sewer System for the above listed property - Permit Type: Residential ☒, Commercial _____, Industrial _____, or Governmental/Institutional _____. User Information _____.

All workmanship and materials shall conform to the standards of the District Ordinance as described in Ordinance 84-2 and 84-3 as amended. Acceptance and approval must be made by the District inspector or his duly authorized representative before backfilling and final connection is made to the main sewer lines. Any violation of applicable regulations will cause all lines and appurtenances in violation to be removed and replaced at the owners expense.

The Fall Creek Regional Waste District is responsible for the inspection, approval of materials, and installation techniques only. All costs for materials and installation and any liabilities resulting from same is the sole responsibility of the property owner.

I have read and fully understand the above provisions and agree to comply by said provisions.

Arthur Owen Emmerring
APPLICANT(S) SIGNATURE

INSPECTOR JERRY

Date inspected 8/15/98 Approved ☒ Rejected _____

Reason for rejection _____

Date reinspected _____ Approved _____ Rejected _____

Notes:

Size Pipe 6"

Type Pipe SDR 26

Basement Yes _____ No ☒

Sump Pump Yes _____ No ☒

Downspout to Ground Yes ☒ No _____


Septic Tank Pumped & filled Yes ☒ No _____

Contractor MCM INC.

Special Conditions _____

Existing Home ☒

New Construction _____

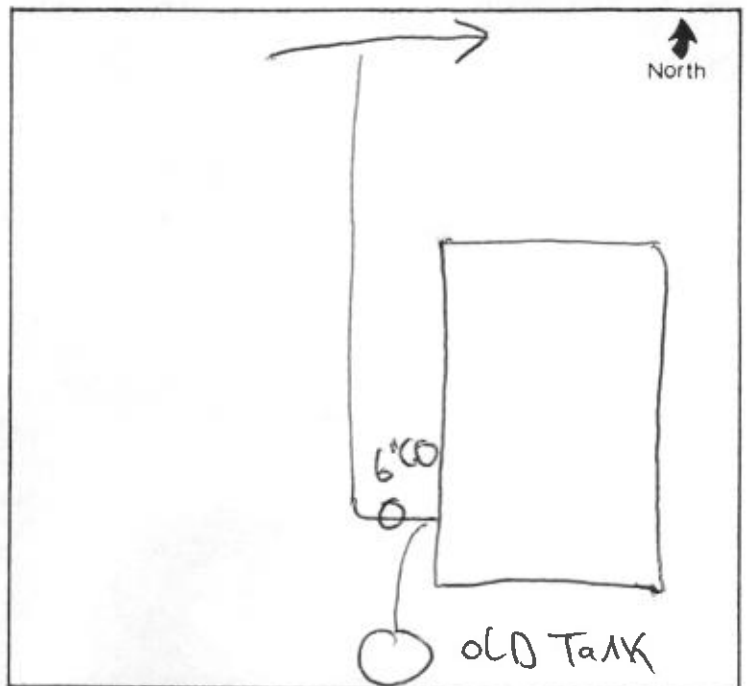



FALL CREEK REGIONAL WASTE DISTRICT

4378 S. 25th West, PO Box 25
Bend, Oregon 97701-0025

23-0146-00

2533

WATER SYSTEM FOR RENT

7-27-88

THIS IS TO CERTIFY THAT THE FOLLOWING INFORMATION WAS RECEIVED FROM THE

OWNER OF THE PROPERTY DESCRIBED BELOW:

PROPERTY ADDRESS: 3121 W. MARKET ST.

CITY: BEND, OREGON

ZIP CODE: 97701

PHONE: (503) 325-2424

NAME: NA

DATE: NA

INSPECTION DATE: NA

INSPECTION TIME: NA

INSPECTION BY: NA

INSPECTION RESULTS: NA

INSPECTION COMMENTS: NA

INSPECTION SIGNATURE: NA

INSPECTION DATE: NA

INSPECTION TIME: NA

INSPECTION BY: NA

INSPECTION RESULTS: NA

INSPECTION COMMENTS: NA

INSPECTION SIGNATURE: NA

INSPECTION DATE: NA


INSPECTION TIME: NA

INSPECTION BY: NA

INSPECTION RESULTS: NA

INSPECTION COMMENTS: NA

INSPECTION SIGNATURE: NA

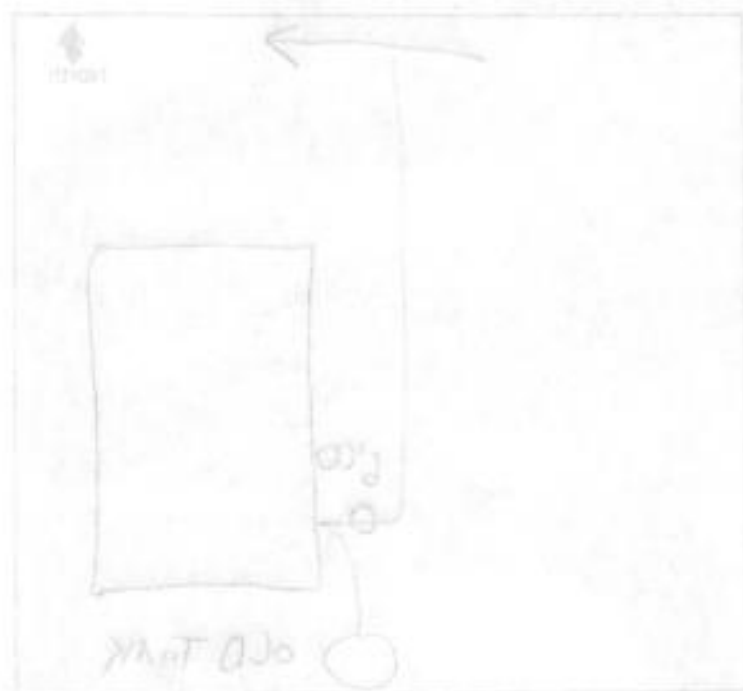

1. The tank is 10' x 10' x 10'.

2. The tank is made of steel.

3. The tank is painted with a red paint.

4. The tank is located in the basement of the building.

5. The tank is used for storing water.

6. The tank is connected to the water supply line.

7. The tank is connected to the water distribution line.

8. The tank is connected to the water meter.

9. The tank is connected to the water main.

10. The tank is connected to the water service line.