



FALL CREEK REGIONAL WASTE DISTRICT

9378 S. 650 West PO Box 59  
Pendleton, IN 46064-0059 778-7544

23-00920.00

APPLICATION FOR SEWER PERMIT

Nº 2652

Date 11-9-98

Permit Void 90 days from Date of Issuance

Owner Name IMOTHY J. REIS

Property Address 3128 W. HUNTSVILLE RD.

Lot # \_\_\_\_\_ P.O. Box \_\_\_\_\_

Town Pendleton, IN Zip Code 46064

Phone 765 778 4856 City Water \_\_\_\_\_ Well X

\$ N/A Tap on Fee Paid

\$ N/A Inspection fee paid

Application is hereby made for connection to the Fall Creek Regional Waste District Sewer System for the above listed property - Permit Type: Residential X, Commercial \_\_\_\_\_, Industrial \_\_\_\_\_, or Governmental/Institutional \_\_\_\_\_. User Information \_\_\_\_\_.

All workmanship and materials shall conform to the standards of the District Ordinance as described in Ordinance 84-2 and 84-3 as amended. Acceptance and approval must be made by the District inspector or his duly authorized representative before backfilling and final connection is made to the main sewer lines. Any violation of applicable regulations will cause all lines and appurtenances in violation to be removed and replaced at the owners expense.

The Fall Creek Regional Waste District is responsible for the inspection, approval of materials, and installation techniques only. All costs for materials and installation and any liabilities resulting from same is the sole responsibility of the property owner.

I have read and fully understand the above provisions and agree to comply by said provisions.

[Signature]  
APPLICANT(S) SIGNATURE

\*\*\*\*\*

INSPECTOR [Signature]

Date inspected 11-9-98 Approved ✓ Rejected \_\_\_\_\_

Reason for rejection \_\_\_\_\_

Date reinspected \_\_\_\_\_ Approved \_\_\_\_\_ Rejected \_\_\_\_\_

Notes:

Size Pipe 6 "

Type Pipe PVC 26160

Basement Yes ✓ No \_\_\_\_\_

Sump Pump Yes \_\_\_\_\_ No ✓

Downspout to Ground Yes ✓ No \_\_\_\_\_


Septic Tank Pumped & filled Yes ✓ No \_\_\_\_\_

Contractor EARL DAVIS

Special Conditions \_\_\_\_\_

Existing Home ✓

New Construction \_\_\_\_\_

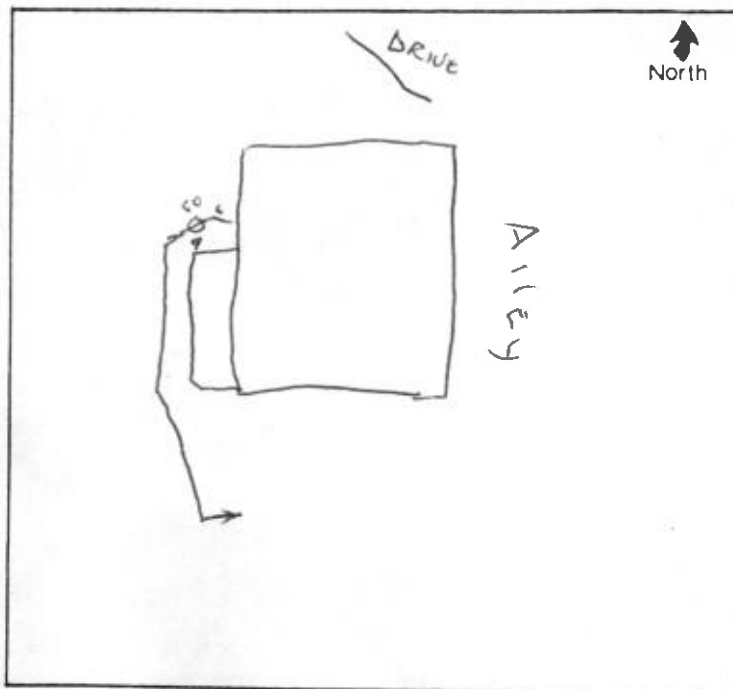



FALL CREEK REGIONAL WASTE DISTRICT  
 3075 E. 600 West PO Box 99  
 Ponderosa, IN 46044-0099 778-3341

12-10-2000

IN 2825

Application for Sewer Permit

Date 11/19/98

Project Name: 11000TH AVE  
 Property Address: 3150 W. Harrisonville Rd  
 City: St. Louis  
 State: MO  
 Zip: 63111  
 Applicant: W/A  
 Designated Use: W/A

Application is hereby made for extension to the Fall Creek Regional Waste District to collect and dispose of the following waste materials:  
 Residential ☒ Commercial ☐ Industrial ☐ Institutional ☐ Other ☐

All buildings and structures shall comply with the standards of the Department of Health and Environment in Missouri 10-2 and 10-7 as amended. The applicant shall provide a site plan showing the location of the building and the location of the sewer connection. The applicant shall also provide a copy of the building permit and the plumbing permit for the building.

The Fall Creek Regional Waste District is responsible for the installation of the sewer line and the installation of the sewer connection. The applicant shall provide a copy of the building permit and the plumbing permit for the building.

I have read and hereby certify that the above information and agree to

APPROVED BY:

Date Issued: 11-19-98

Project No: 11000TH AVE

City: St. Louis

State: MO

Zip: 63111

Applicant: W/A

Designated Use: W/A

Project Name: 11000TH AVE

Property Address: 3150 W. Harrisonville Rd

City: St. Louis

State: MO

Zip: 63111

