


Gidw.

PROJECT Phase II SHEET _____ OF _____
SUBJECT _____ DATE 6-20-18
JOB NO. 4447
BY Atlas

312 E. Clark

↑
N

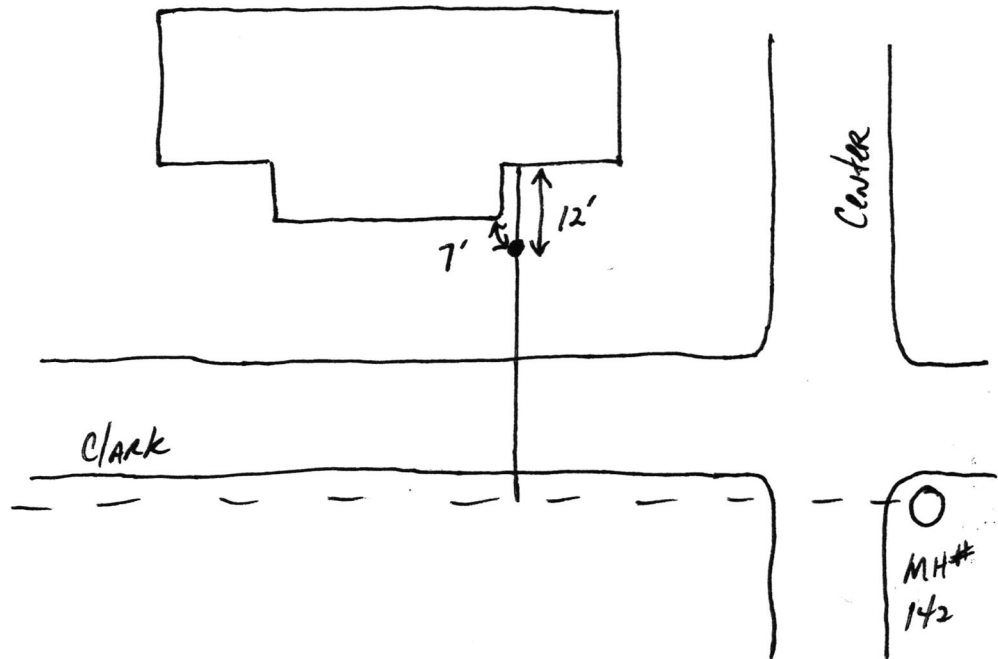

31a Clark

S&F Phase II

6.21.18

