


Gidw.

PROJECT Phase II SHEET _____ OF _____

SUBJECT _____ DATE 7-11-18

JOB NO. 4447

BY Atlas

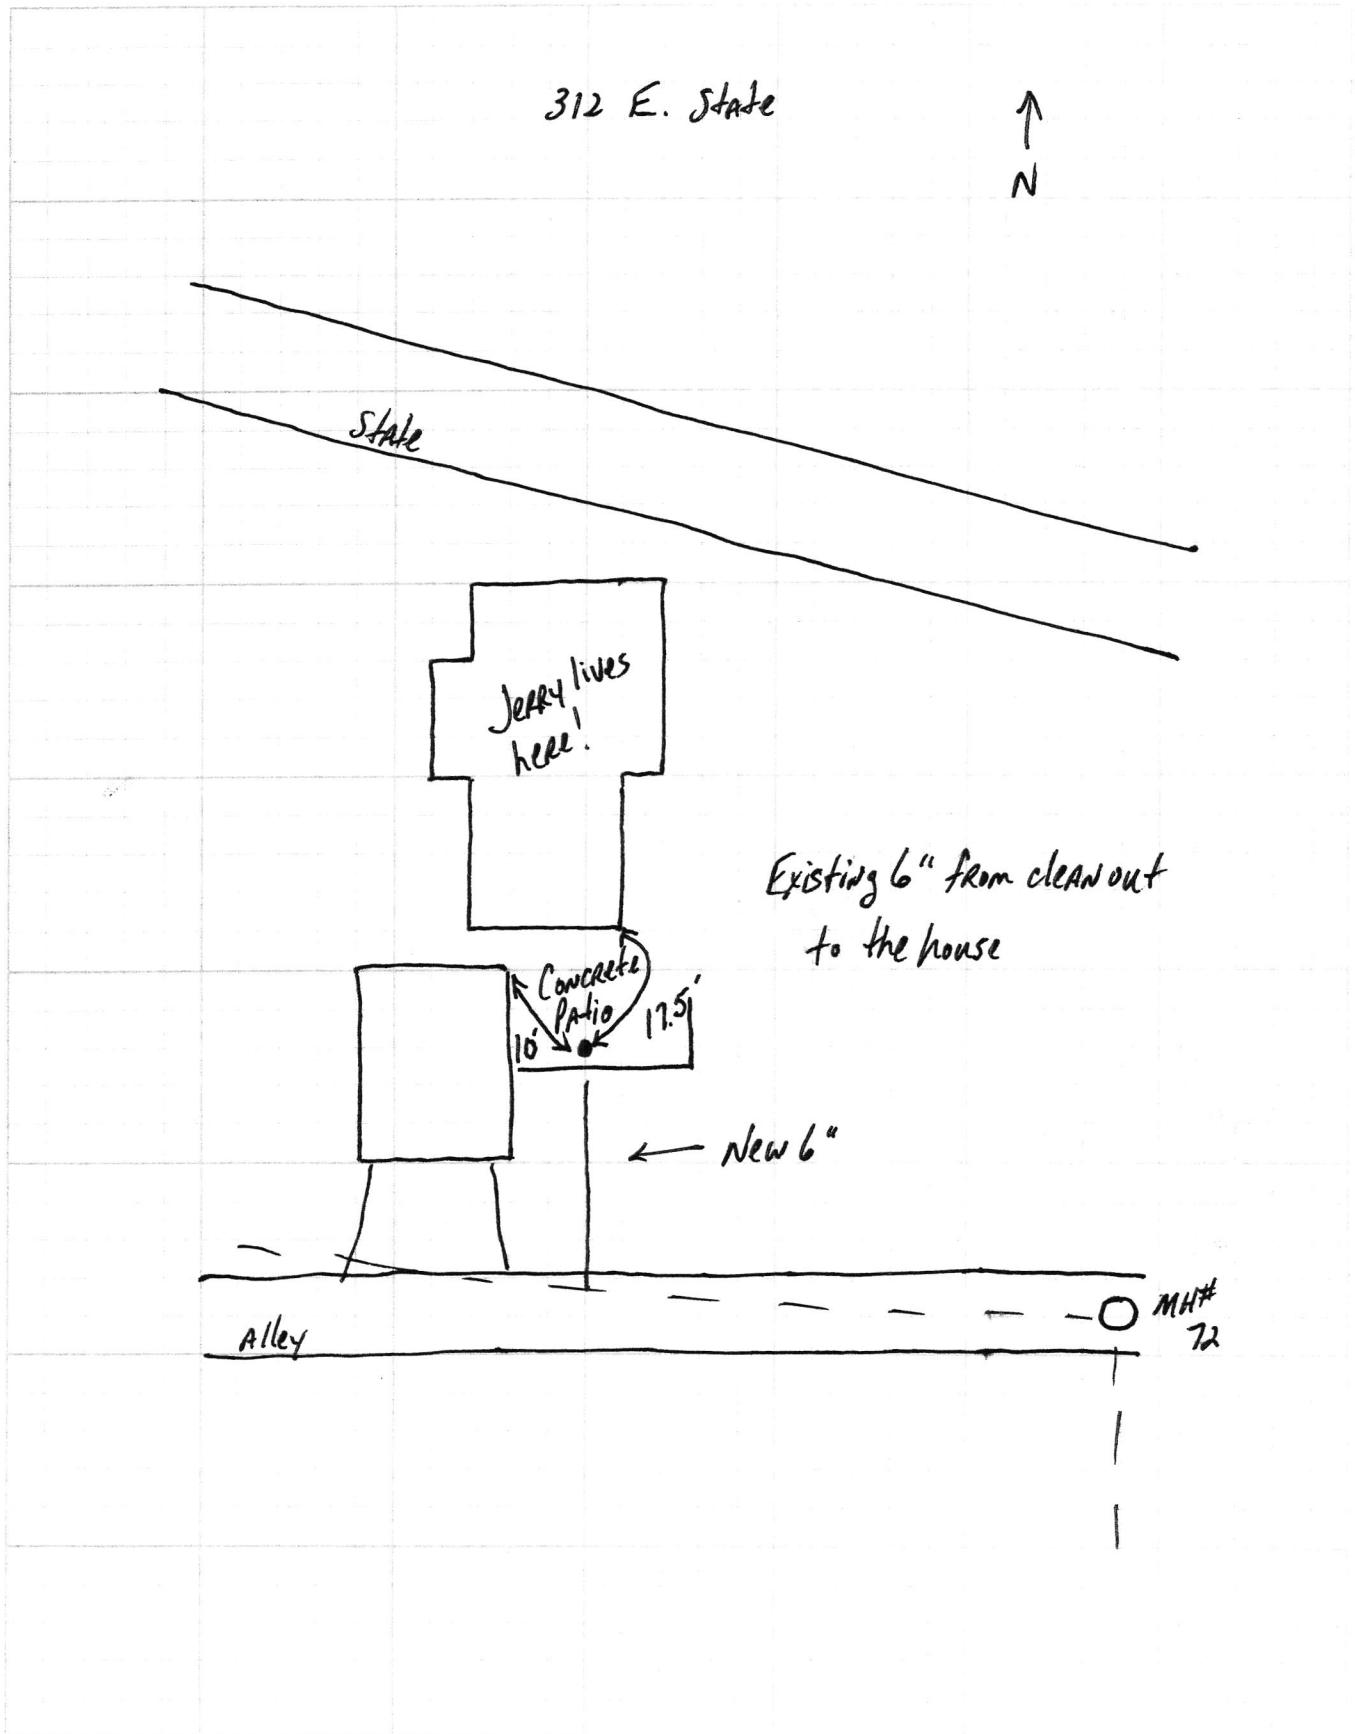

010 C Stack

Self Phase II

81-81-2

