




Gidw.

PROJECT Phase II SHEET \_\_\_\_\_ OF \_\_\_\_\_  
SUBJECT \_\_\_\_\_ DATE 7-12-18  
JOB NO. 4447  
BY Atlas

312 Franklin

Tile

Franklin

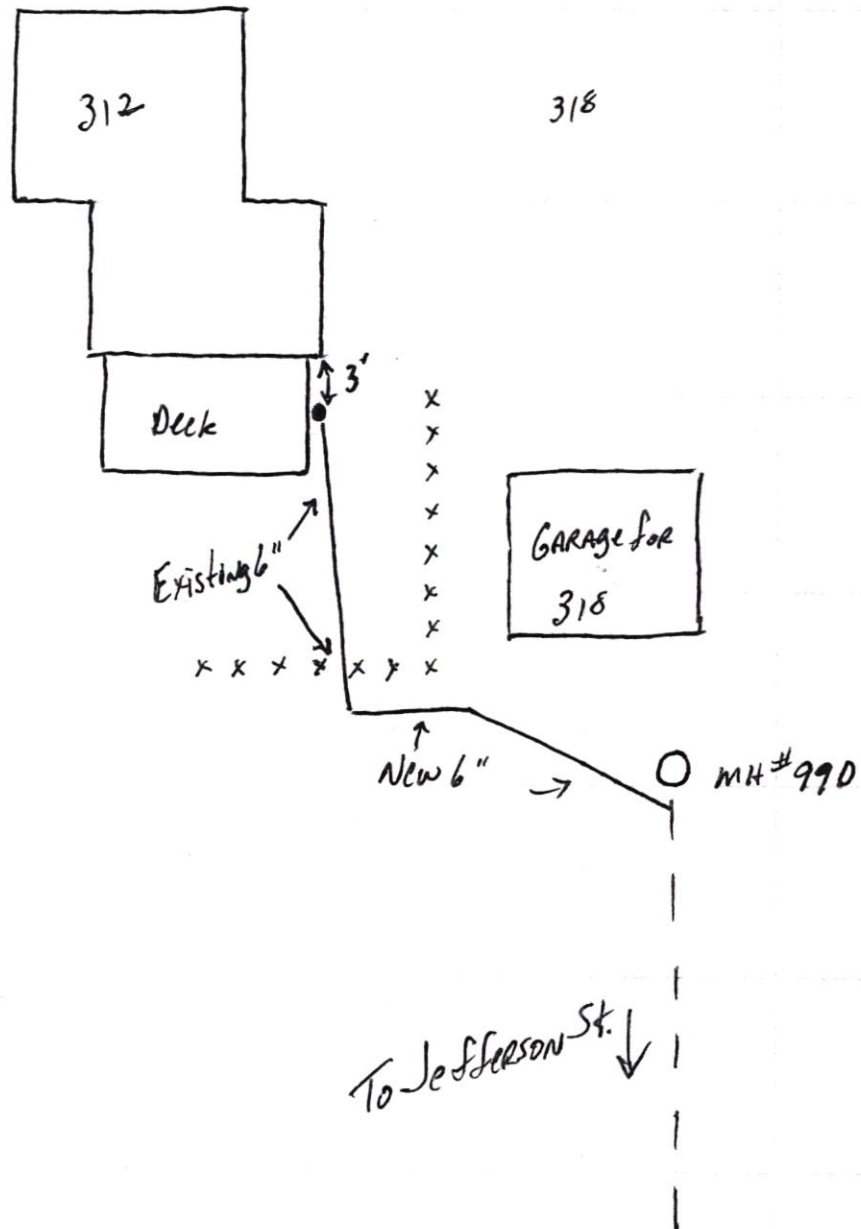



312 Franklin

SRP  
Phase II

4.20.18

