



FALL CREEK REGIONAL WASTE DISTRICT

Box 44, Pendleton, Indiana 46064

3-1024330.00

Nº 001661

APPLICATION FOR SEWER PERMIT

Permit No. _____ Date 12-20-88
Permit Void 90 days from Date of Issuance
Owner Name DR. Douglas Johnson
Property Address 3132 St Rd 38
Lot # _____ P.O. Box _____
Town Pendleton, IN Zip Code 46064
Phone _____ Water Meter Read."
\$ 2880.00 Tap on Fee Paid pd 3-14-89
\$ 25.00 Inspection fee paid

Application is hereby made for connection to the Fall Creek Regional Waste District Sewer System for the above listed property - Permit Type: Residential _____, Commercial X, Industrial _____, or Governmental/Institutional _____. User Information _____.

All workmanship and materials shall conform to the standards of the District Ordinance as described in Ordinance 84-2 and 84-3 as amended. Acceptance and approval must be made by the District inspector or his duly authorized representative before backfilling and final connection is made to the main sewer lines. Any violation of applicable regulations will cause all lines and appurtenances in violation to be removed and replaced at the owners expense.

The Fall Creek Regional Waste District is responsible for the inspection, approval of materials, and installation techniques only. All costs for materials and installation and any liabilities resulting from same is the sole responsibility of the property owner.

I have read and fully understand the above provisions and agree to comply by said provisions.

APPLICANT(S) SIGNATURE

INSPECTOR B

Date inspected 12-20-88 Approved ✓ Rejected _____

Reason for rejection _____

Date reinspected _____ Approved _____ Rejected _____

Notes:

Size Pipe 6"

Type Pipe PVC

Basement Yes X No _____

Sump Pump Yes _____ No X

Downspout to Ground Yes X No _____

Septic Tank Pumped & filled Yes _____ No X

Contractor Dick Godbey


Special Conditions TAP TO FORCE

MAIN'S 20' NORTH of CLANCEY'

NORTH PROPERTY LINE

21' EAST of EAST edge of

67 main Road

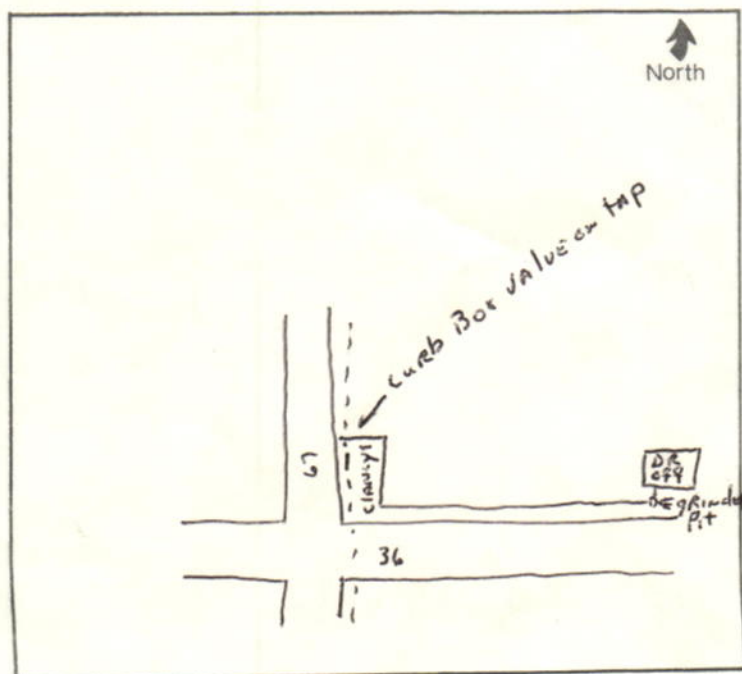



FALL CREEK REGIONAL WASTE DISTRICT

Box 59, County Road 650 West, Pendleton, Indiana, 46064 (317) 778-3983

February 15, 1989

Douglas Johnson, DDS
210 E Water Street
Pendleton, IN 46064

RE: Sewer System

Dear Doctor Johnson:

Please consider this an invoice for the purchase of a Grinder Pump System and Inspection of the installation of such system.

Grinder Pump System	\$2,880.00
Inspection	<u>25.00</u>
TOTAL DUE	\$2,905.00

Please make the check payable to Fall Creek Regional Waste District and mail to P.O. Box 59, Pendleton, IN 46064. If you should have questions, please contact our office.

Respectfully,

Dod Nobel
General Manager

tkh



21' E of Main Hwy
 20' N of Cawley's Property
 4' Deep

Dewest Sewer TAP

Dick's Property Cont.

313a W SL 38 Tap

Tim Melendy 2019

