

Gidw.


PROJECT Phase II SHEET _____ OF _____

SUBJECT _____ DATE 5-14-18

JOB NO. 4447

BY _____

313 S. MAIN

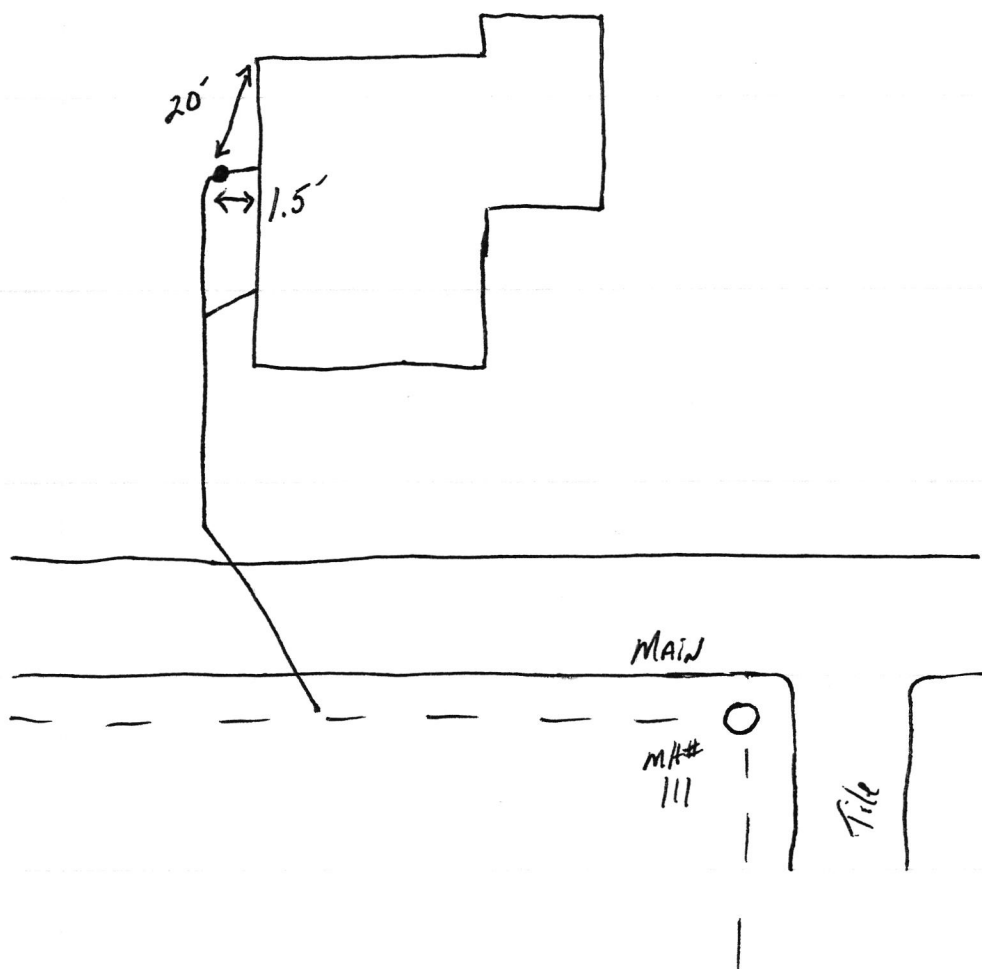



313 S Main St

Sgt Phase II

S. 22.18