

Gidw.

PROJECT

Phase II

SHEET

OF

SUBJECT

DATE

7-11-18

JOB NO.


4447

BY

A-HAS

314 E. High

↑
N

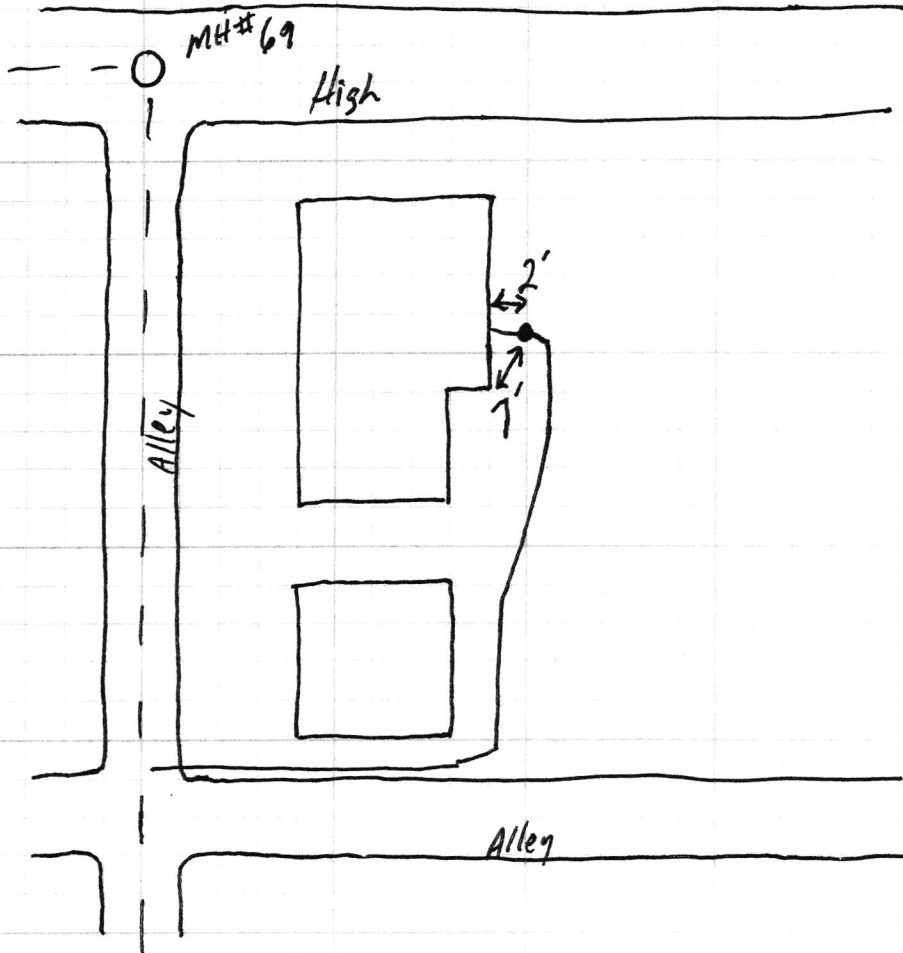

314 & High

SRF Phase II

7.18.18

