

Gidw.

PROJECT Phase II SHEET \_\_\_\_\_ OF \_\_\_\_\_


SUBJECT \_\_\_\_\_ DATE 6-3-18

JOB NO. 4447

BY Atlas

314 S. Jefferson

N →

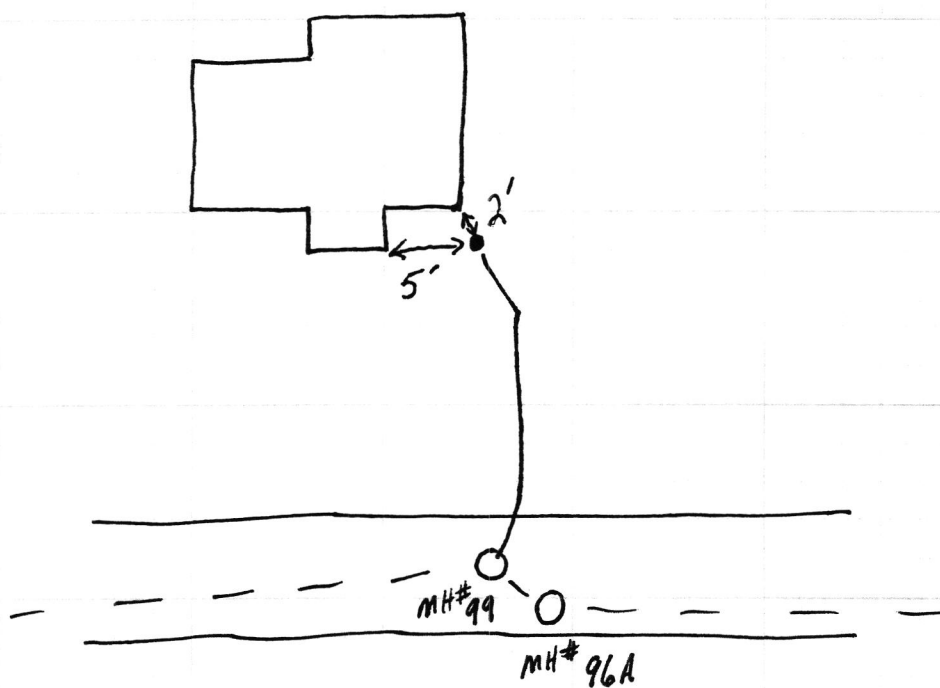

314 S Jefferson

SRF Phase II

6.11.18

