



FALL CREEK REGIONAL WASTE DISTRICT

9378 S. 650 West PO Box 59
Pendleton, IN 46064-0059 778-7544

23-00980.00

APPLICATION FOR SEWER PERMIT

Nº 2599

Date 8-28-98

Permit Void 90 days from Date of Issuance

Owner Name Clint Hinkle

Property Address 3153 Huntsville Rd

Lot # _____ P.O. Box _____

Town Pendleton, IN Zip Code 46064

Phone _____ City Water _____ Well _____

\$ X Tap on Fee Paid

\$ X Inspection fee paid

Application is hereby made for connection to the Fall Creek Regional Waste District Sewer System for the above listed property - Permit Type: Residential ☒, Commercial _____, Industrial _____, or Governmental/Institutional _____. User Information _____

All workmanship and materials shall conform to the standards of the District Ordinance as described in Ordinance 84-2 and 84-3 as amended. Acceptance and approval must be made by the District inspector or his duly authorized representative before backfilling and final connection is made to the main sewer lines. Any violation of applicable regulations will cause all lines and appurtenances in violation to be removed and replaced at the owners expense.

The Fall Creek Regional Waste District is responsible for the inspection, approval of materials, and installation techniques only. All costs for materials and installation and any liabilities resulting from same is the sole responsibility of the property owner.

I have read and fully understand the above provisions and agree to comply by said provisions.

Christell E. Hinkle
APPLICANT(S) SIGNATURE

INSPECTOR Tim

Date inspected 9-2-98 Approved ☒ Rejected _____

Reason for rejection _____

Date reinspected _____ Approved _____ Rejected _____

Notes:

Size Pipe 4"

Type Pipe SDR 35

Basement Yes ☒ No _____

Sump Pump Yes ☒ No _____

Downspout to Ground Yes ☒ No _____


Septic Tank Pumped & filled Yes ☒ No _____

Contractor GARL DAVIS

Special Conditions _____

Existing Home ☒

New Construction _____

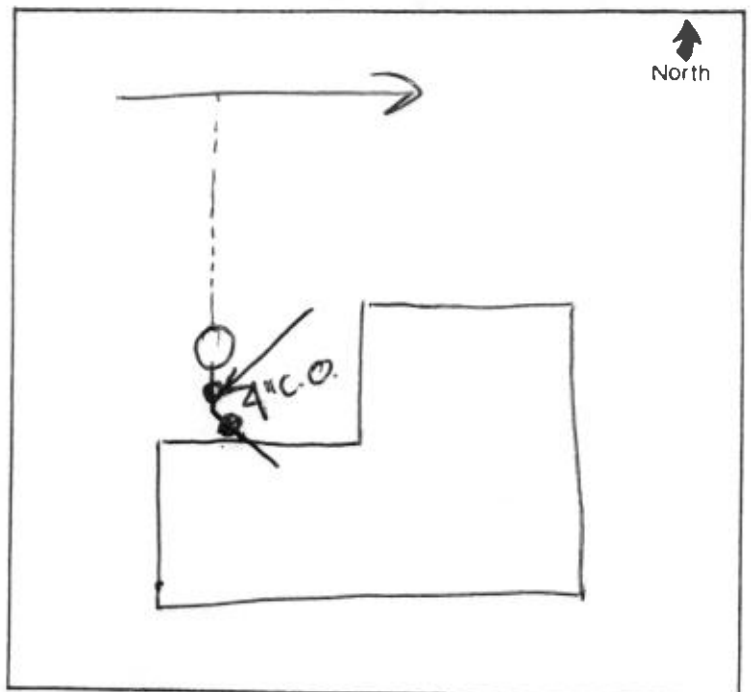

FALL CREEK REGIONAL WASTE DISTRICT

8378 S. 650 West PO Box 83
Vandalia, IN 46061-0083 778-7844



33-CCP80-00

No 2299

AGREEMENT FOR SEWER SERVICE

Date 8-26-98

Partis Void 90 days from Date of Issuance

Owner Name Glenn Hinkle

Property Address 523 West 1st St

Lot # 100

Block 100

Subdivision 100

Map No. 100

Map Date 10-1-97

Map Scale 1" = 100'

Map Source 100

Map Date 10-1-97

Map Scale 1" = 100'

Map Source 100

Application is hereby made for connection to the Fall Creek Regional Waste Water Treatment Plant. The above is a true and correct copy of the original application as filed with the District Engineer. The District Engineer has reviewed the application and has determined that the same complies with the requirements of the District Engineer. The District Engineer has also determined that the same complies with the requirements of the District Engineer. The District Engineer has also determined that the same complies with the requirements of the District Engineer.

The Fall Creek Regional Waste Water Treatment Plant is responsible for the collection, treatment and disposal of wastewater from the community. The District Engineer has determined that the same complies with the requirements of the District Engineer. The District Engineer has also determined that the same complies with the requirements of the District Engineer. The District Engineer has also determined that the same complies with the requirements of the District Engineer.

I have read and understand the above and agree to the terms and conditions of this agreement. My signature is as follows:


Glenn Hinkle
District Engineer

DATE APPROVED 8-26-98 BY Tim

RECEIVED FOR 100

APPROVED 100

RECEIVED FOR 100

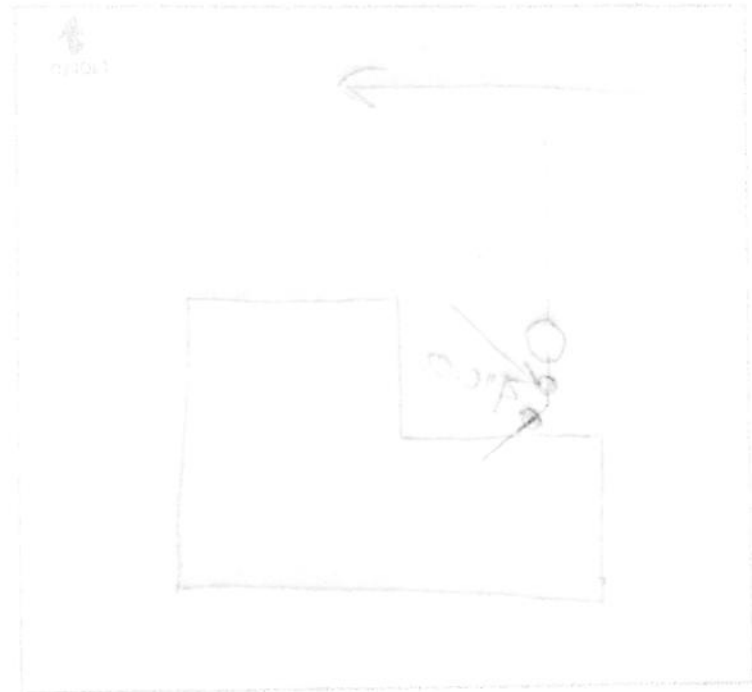

DATE 8-26-98

TIME 10:00

LOCATION 100

REMARKS 100

APPROVED 100

RECEIVED FOR 100