

Fall Creek Regional Waste District
9378 S 650 W, P.O. Box 59, Pendleton, IN 46064
765-778-7544

#8592

Agreement for Sanitary Sewer Service

This Agreement made and entered into this 20 day of July, 2024, between Fall Creek Regional Waste District ("District") and Morris DeShong ("Applicant") regarding the provision of sanitary sewer service, and the assignment of capacity in and connection to, the District's facilities for the premises located at _____.

Street Address: 315 S Adams - Garage Apartment, Pendleton

Now therefore, the parties, in consideration of the mutual promises set out in this Agreement, the receipt and sufficiency of which is hereby acknowledged, agree as follows:

1. The Applicant agrees that all workmanship and materials shall conform to all District ordinances and the District's construction standards. District must accept and approve all work and materials before backfilling and final connection is made to the sewer mains. Any violation of this provision will cause all lines and appurtenances in violation to be removed and replaced at the Applicant's expense.
2. The District shall have the right to enter upon the Applicant's premises at all reasonable times to inspect, repair, or replace any equipment used in connection with the District's service or which has an impact on said service.
3. The Applicant shall be responsible for all monthly user rates, capacity charges, and tap fees. The failure to pay any rate charge or fee may result in a lien against the property and/or the termination of service to the property, the cost of which will be borne by Applicant, including, but not limited to, all attorney's fees and collection costs.
4. The District shall not be responsible for any damages as a result of any failure to supply service unless said damages are due to default, neglect or culpability on the part of the District.
5. If there is an available sanitary sewer within three hundred (300) feet of the property line, the property owner shall be required to connect to the District's sanitary sewer system.
6. The Applicant and District agree that the provision of sanitary sewer service touches and concerns the property and the terms of this Agreement bind the District and Applicant and their heirs, executors, administrators, personal representatives, successors, agents, attorneys, assigns, designees, and transferees.

The parties hereto have read and fully understand the above provisions and agree to comply with said provisions.

FALL CREEK REGIONAL WASTE DISTRICT
[Signature]
Signature

APPLICANT
[Signature]
Signature

STATE OF INDIANA)
) SS:
COUNTY OF MADISON)

SUBSCRIBED and sworn to before me this ____ day of _____, 20__

My Commission Expires:

Signature _____

Printed _____

Notary Public


Resident of _____ County


Inspector John Date Inspected 7/25/24 Approved X Rejected _____
Reason for Rejection _____

Date Reinspected _____ Approved _____ Rejected _____

Notes:


Size Pipe 4 Type Pipe SDR
Basement Yes No
Sump Pump Yes No
Downspout to Ground Yes No
Septic Tank Pumped & Filled Yes No
Contractor Festler Exc
Special Conditions _____
Existing Home X
New Construction _____

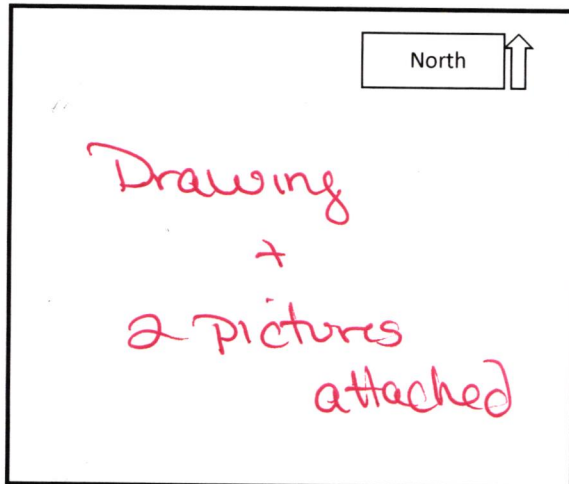

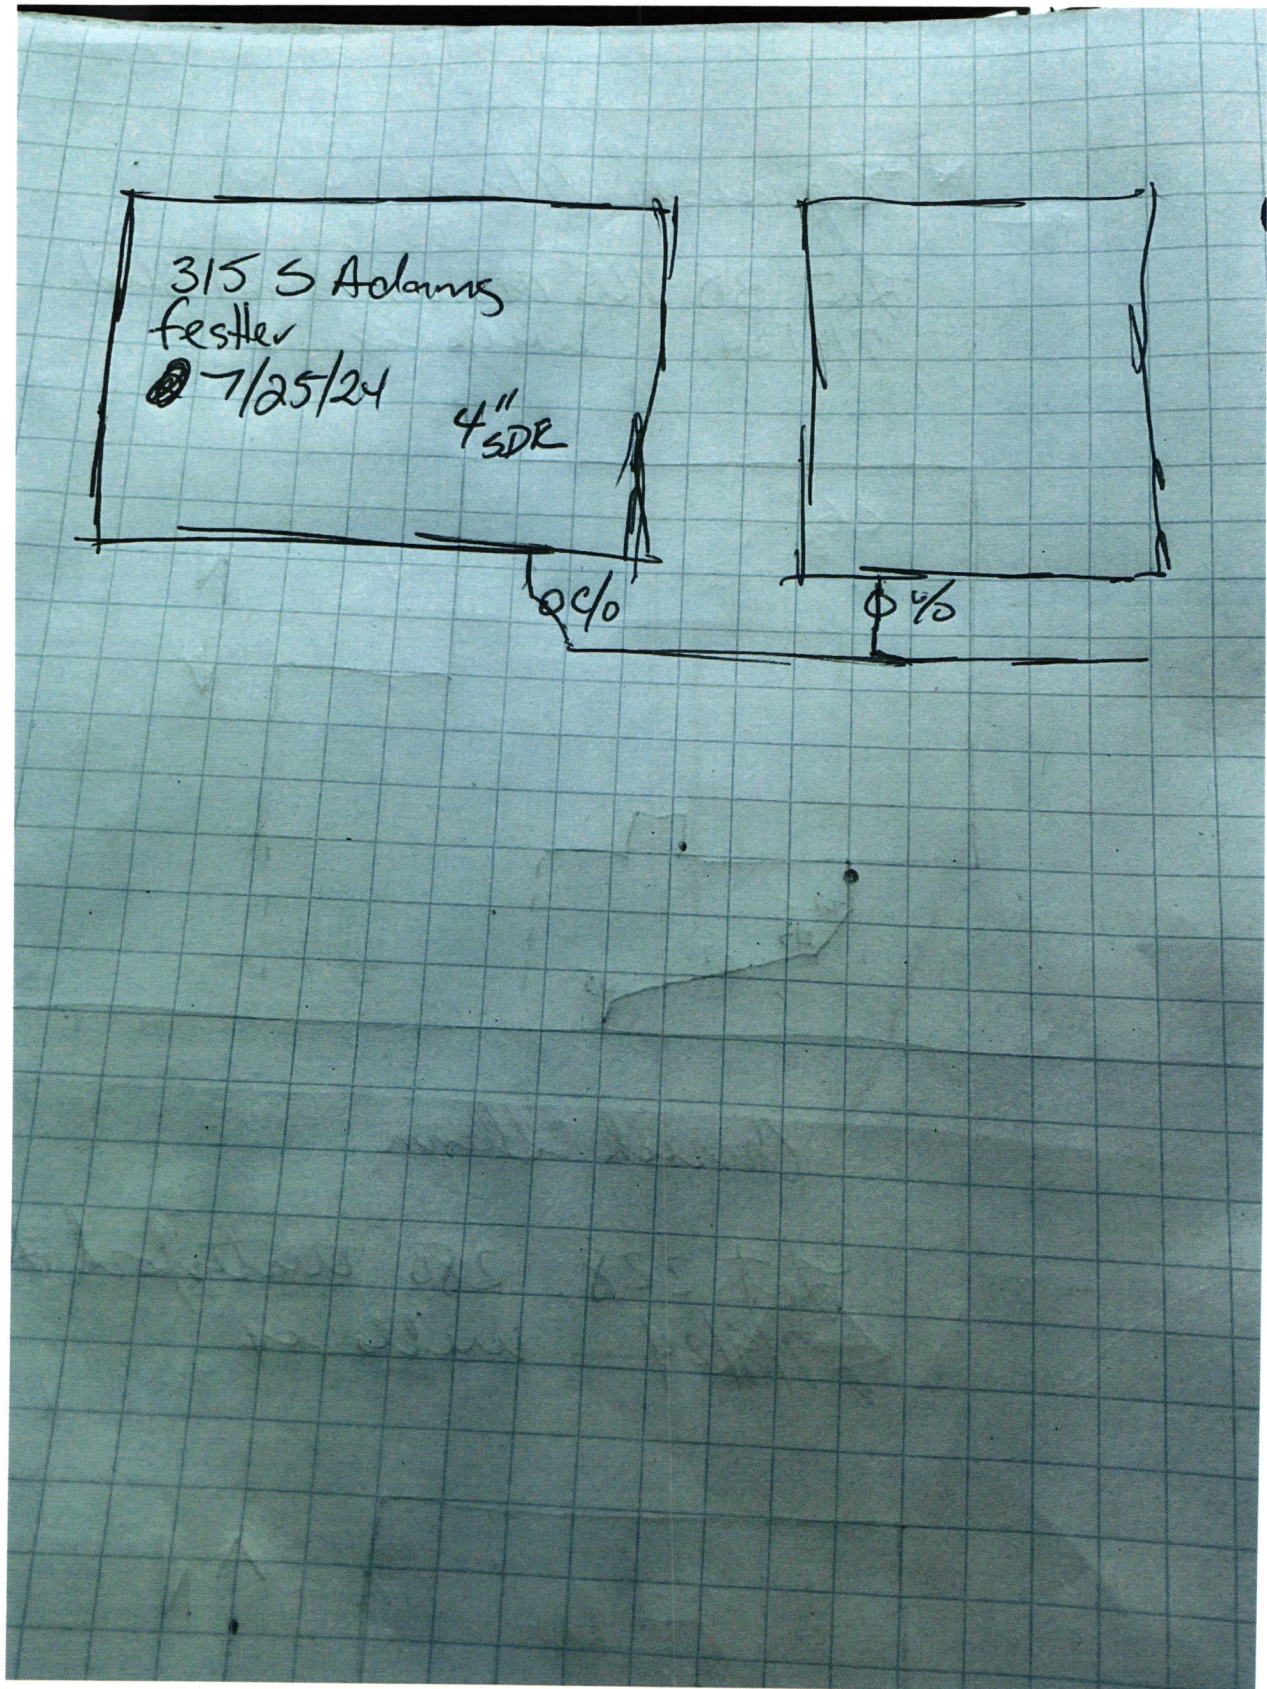





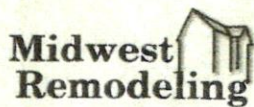

Midwest Remodeling Services, Inc

8575 S State Rd 9
Pendleton, IN 46064
(765)778-8471

Star Financial Bank

71-1677749

21840

7-26-24

PAY TO THE
ORDER OF

FCRLD


\$ 3,400⁰⁰

three thousand four hundred dollars ⁰⁰/₁₀₀

DOLLARS

MEMO

Clean sewer 315 S Adams

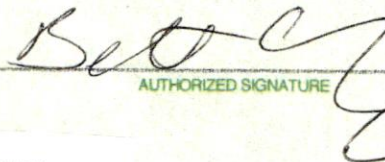
AUTHORIZED SIGNATURE



FALL CREEK REGIONAL WASTE DISTRICT

9378 S. 650 West PO Box 59
Pendleton, IN 46064-0059 778-7544

2-03893.

APPLICATION FOR SEWER PERMIT

No 2089

Date 5-27-94

Permit Void 90 days from Date of Issuance

Owner Name Neil Shull

Property Address 315 Adams St.

Lot # _____ P.O. Box _____

Town Pendleton, IN Zip Code 46064

Phone _____ City Water _____ Well _____

\$ 700.00 Tap on Fee Paid 9/6/94

\$ 25.00 Inspection fee paid 9/6/94

Application is hereby made for connection to the Fall Creek Regional Waste District Sewer System for the above listed property - Permit Type: Residential X, Commercial _____, Industrial _____, or Governmental/Institutional _____. User Information _____.

All workmanship and materials shall conform to the standards of the District Ordinance as described in Ordinance 84-2 and 84-3 as amended. Acceptance and approval must be made by the District inspector or his duly authorized representative before backfilling and final connection is made to the main sewer lines. Any violation of applicable regulations will cause all lines and appurtenances in violation to be removed and replaced at the owners expense.

The Fall Creek Regional Waste District is responsible for the inspection, approval of materials, and installation techniques only. All costs for materials and installation and any liabilities resulting from same is the sole responsibility of the property owner.

I have read and fully understand the above provisions and agree to comply by said provisions.

APPLICANT(S) SIGNATURE

INSPECTOR B

Date inspected 5/26/94 Approved ✓ Rejected _____

Reason for rejection _____

Date reinspected _____ Approved _____ Rejected _____

Notes:

Size Pipe 4"

Type Pipe PVC

Basement Yes _____ No X

Sump Pump Yes _____ No X

Downspout to Ground Yes X No _____


Septic Tank Pumped & filled Yes X No _____

Contractor EARL DAVIS

Special Conditions _____

Existing Home ✓

New Construction _____

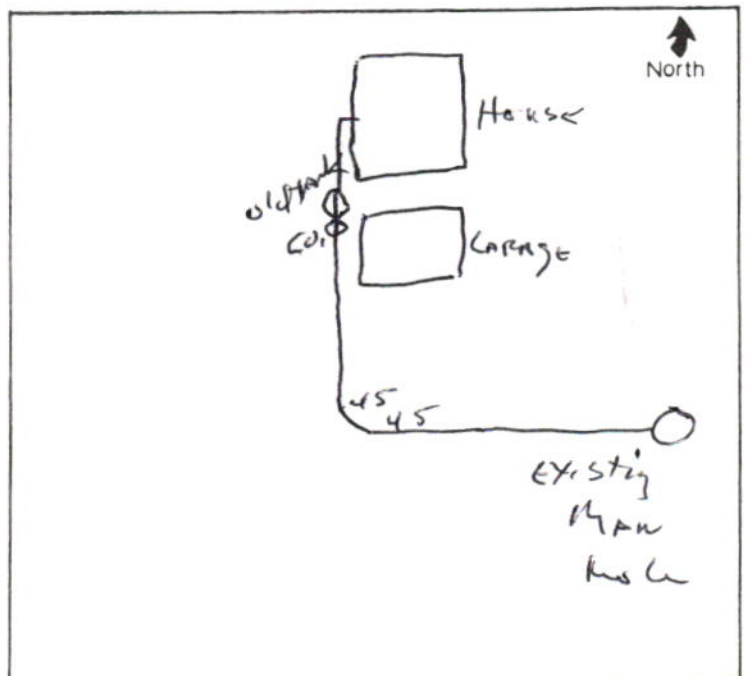

INVOICE

NUMBER

054001

DATE _____

6-28-94

SOLD TO:

SHIPPED TO:

SOLD TO:
Neil Shull
5429 W J.R. 132
Ponderton In 46064

315 Adams St
Purdettown In 46064

CUSTOMER ORDER NO.	OUR ORDER NO.	SALESPERSON	TERMS	FOB	DATE SHIPPED	SHIPPED VIA
					5-26-94	

[illegible]



PROJECT Phase II SHEET _____ OF _____

SUBJECT _____ DATE _____

JOB NO. 4447

BY Atlas

