

Gidw.


PROJECT Phase II SHEET _____ OF _____

SUBJECT _____ DATE 6-9-18

JOB NO 4447

BY Atlas

315 E. Indiana

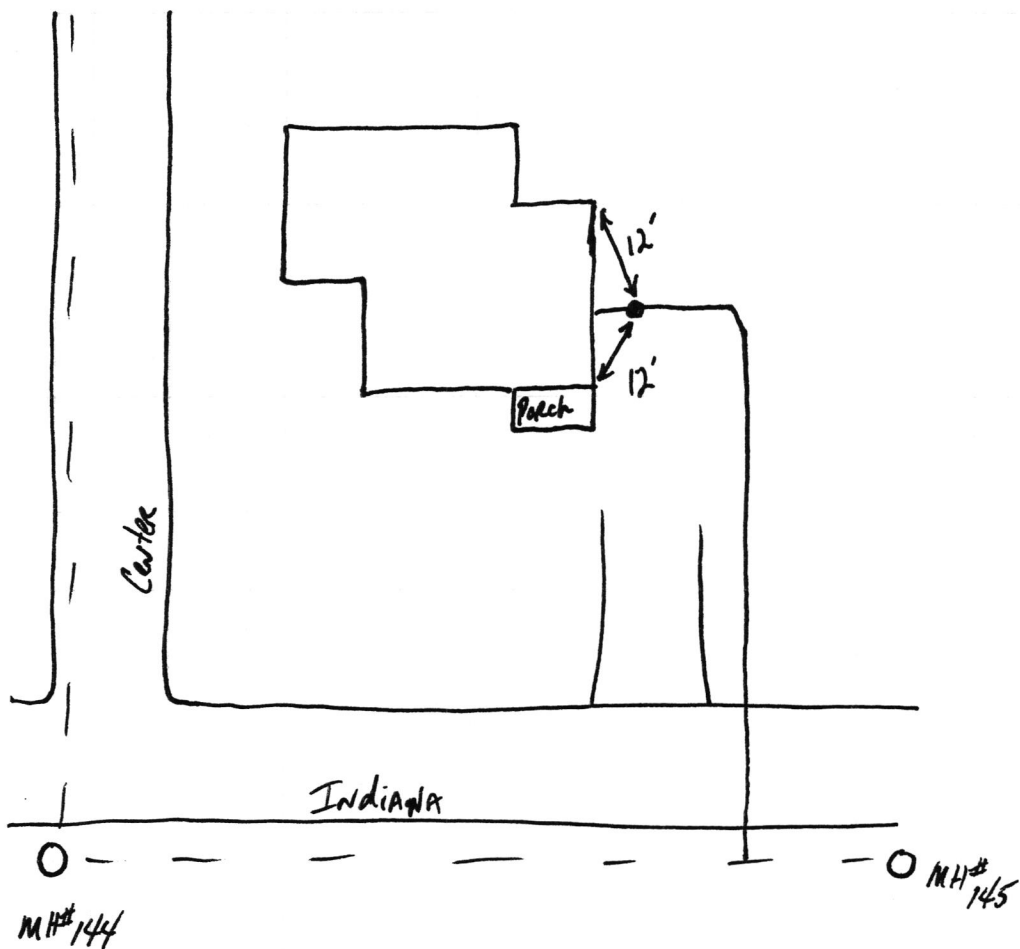

315 Indiana

SRP Phase II

6.19.18

