

**Gidw.**


PROJECT Phase II SHEET \_\_\_\_\_ OF \_\_\_\_\_

SUBJECT \_\_\_\_\_ DATE 2-27-18

JOB NO. 4447

BY Atlas

315 Laurel St.

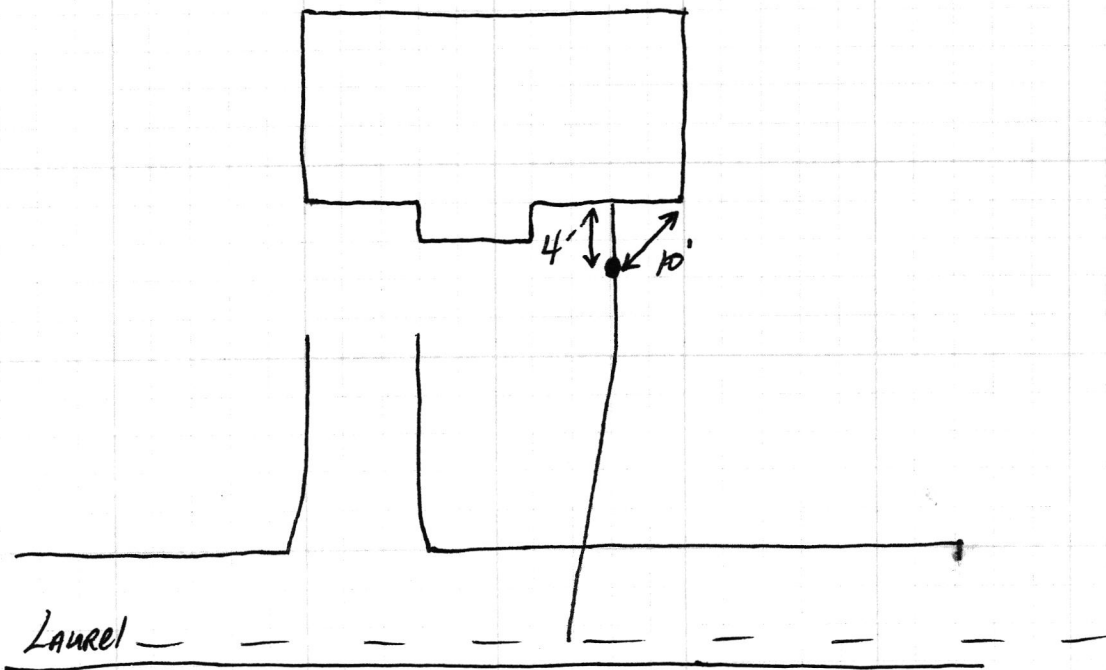

315 Laurel ST

SRF Phase II

